


TOTAL SF AVAILABLE - 5,400 SF


OFFICE - 4,391 SF

WAREHOUSE - 1,009 SF

[Click to access 3D model](#)

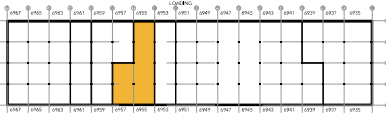

Key Plan

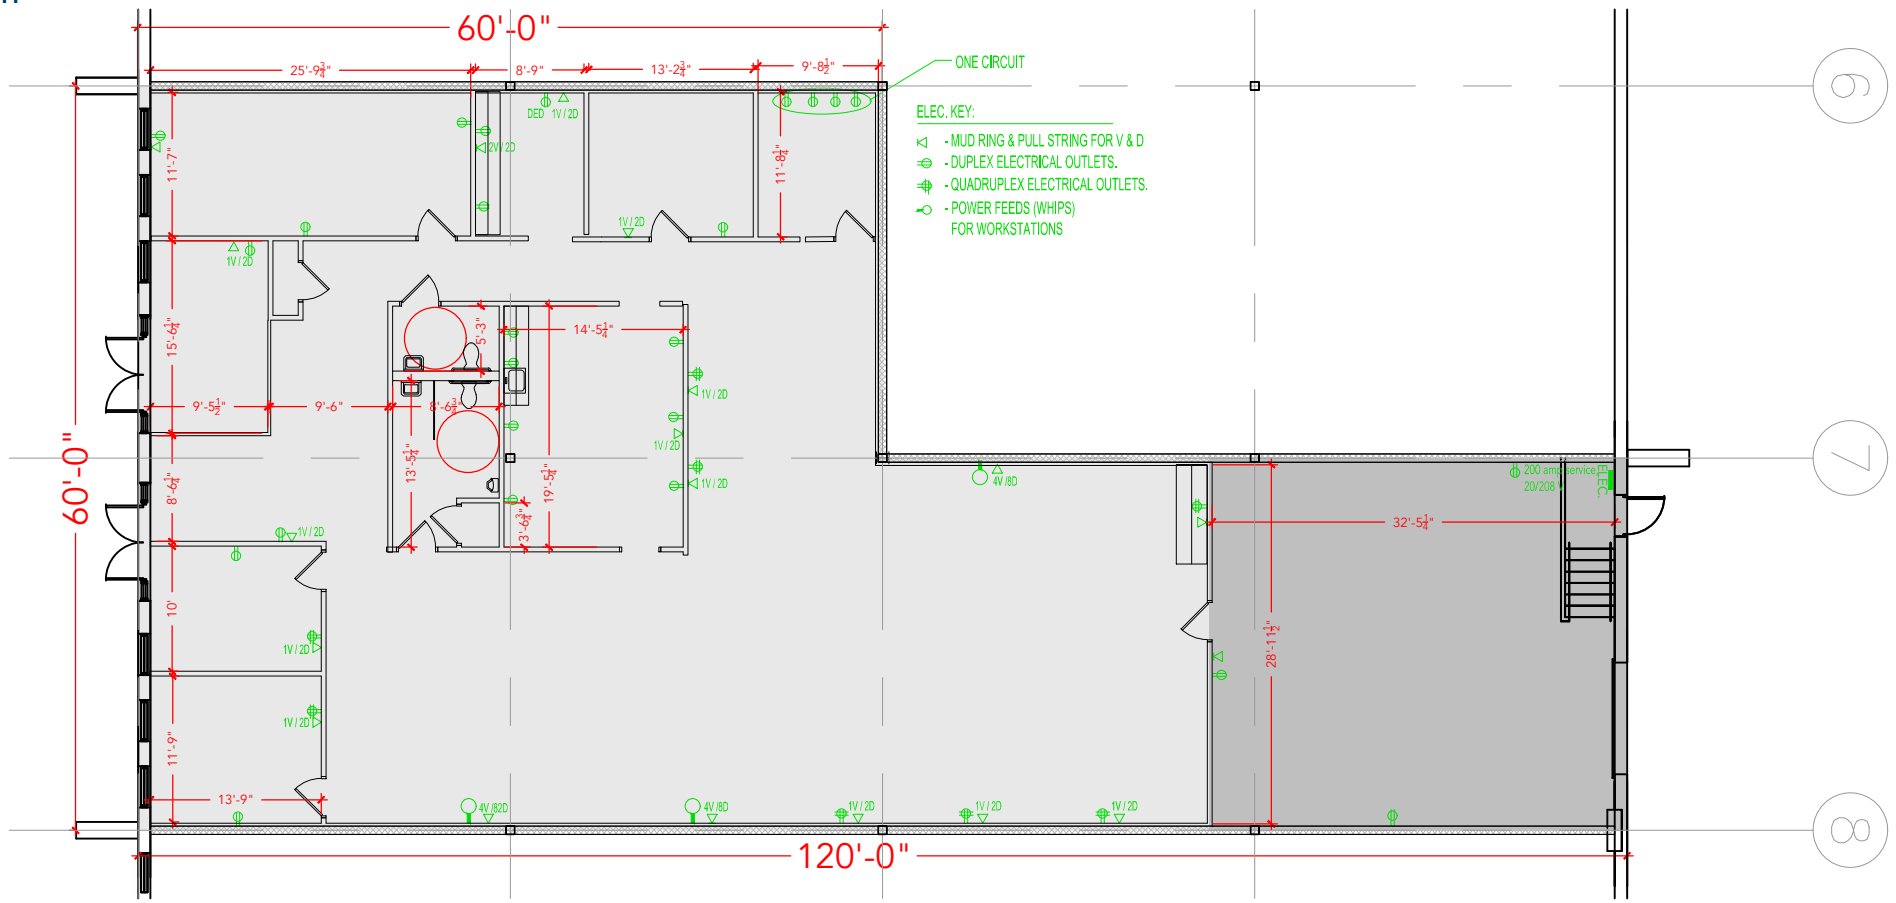

Floor Plan