


**TOTAL SF AVAILABLE - 5,400 SF**


**OFFICE - 4,386 SF**

**WAREHOUSE - 1,014 SF**

[Click to access 3D model](#)

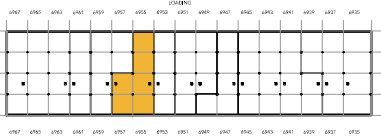

## Key Plan

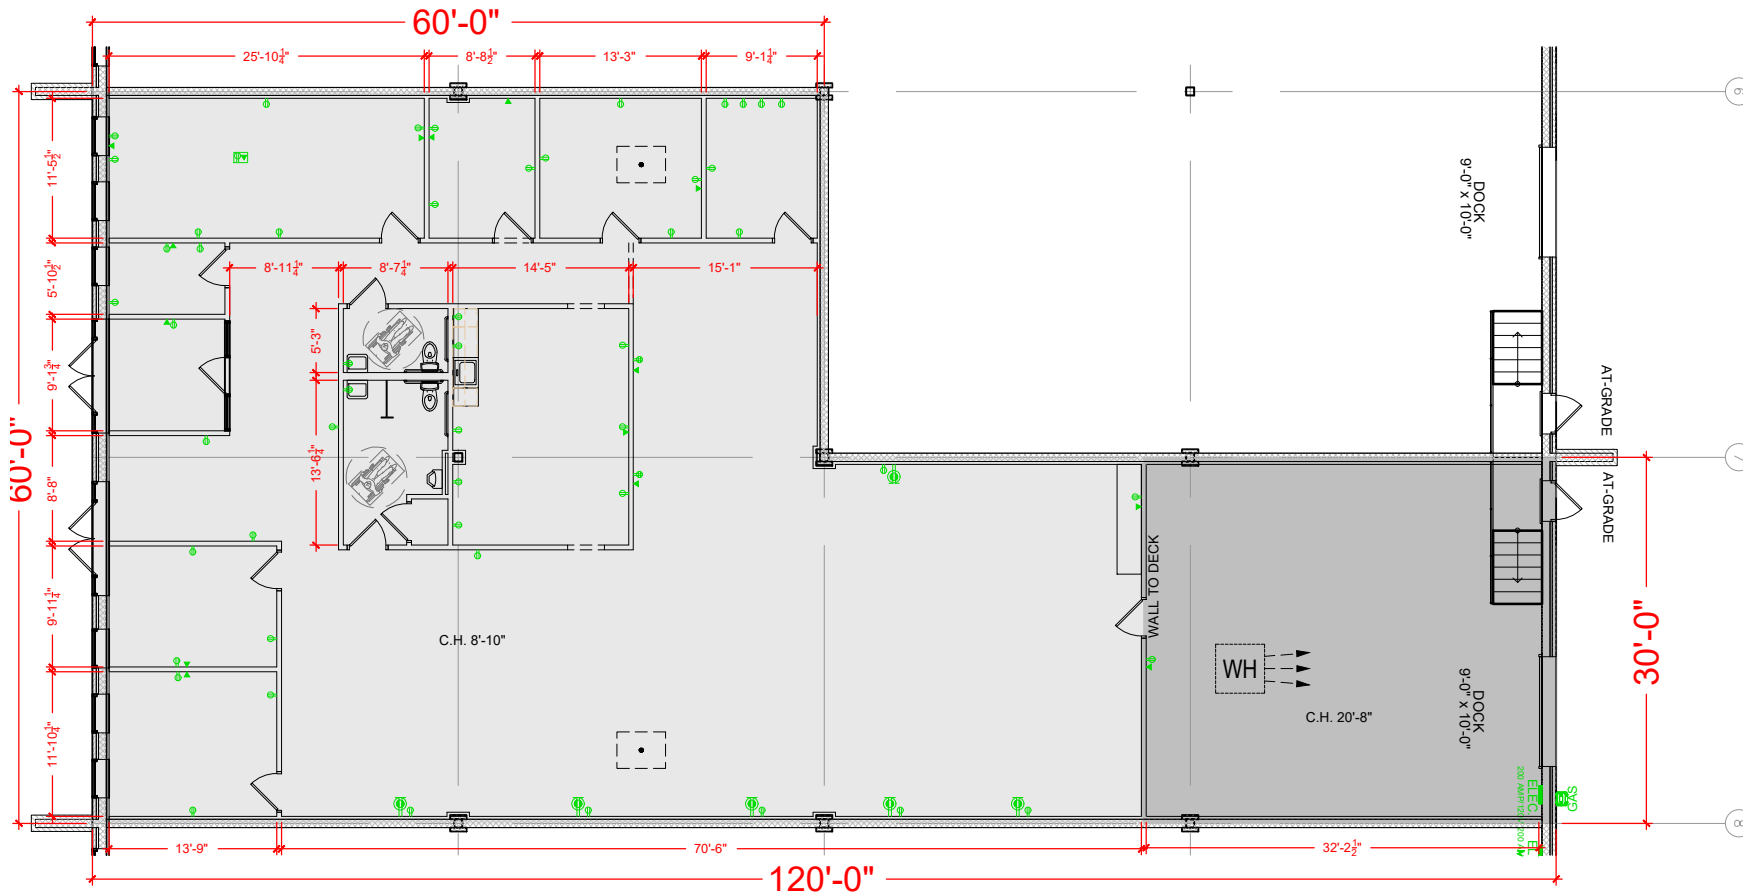

6957

6955

## Floor Plan