


GOLDEN RING II


6935-6967 GOLDEN RING ROAD, BALTIMORE, MD 21237

VACANT
SUITE 6955-6957F

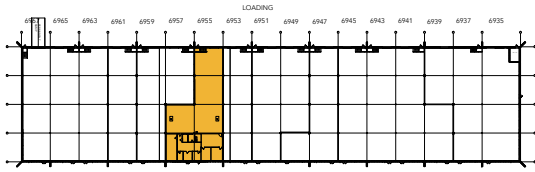

KEY PLAN

TOTAL SF AVAILABLE - 5,400 SF
OFFICE - 1,762 SF
WAREHOUSE - 3,638 SF

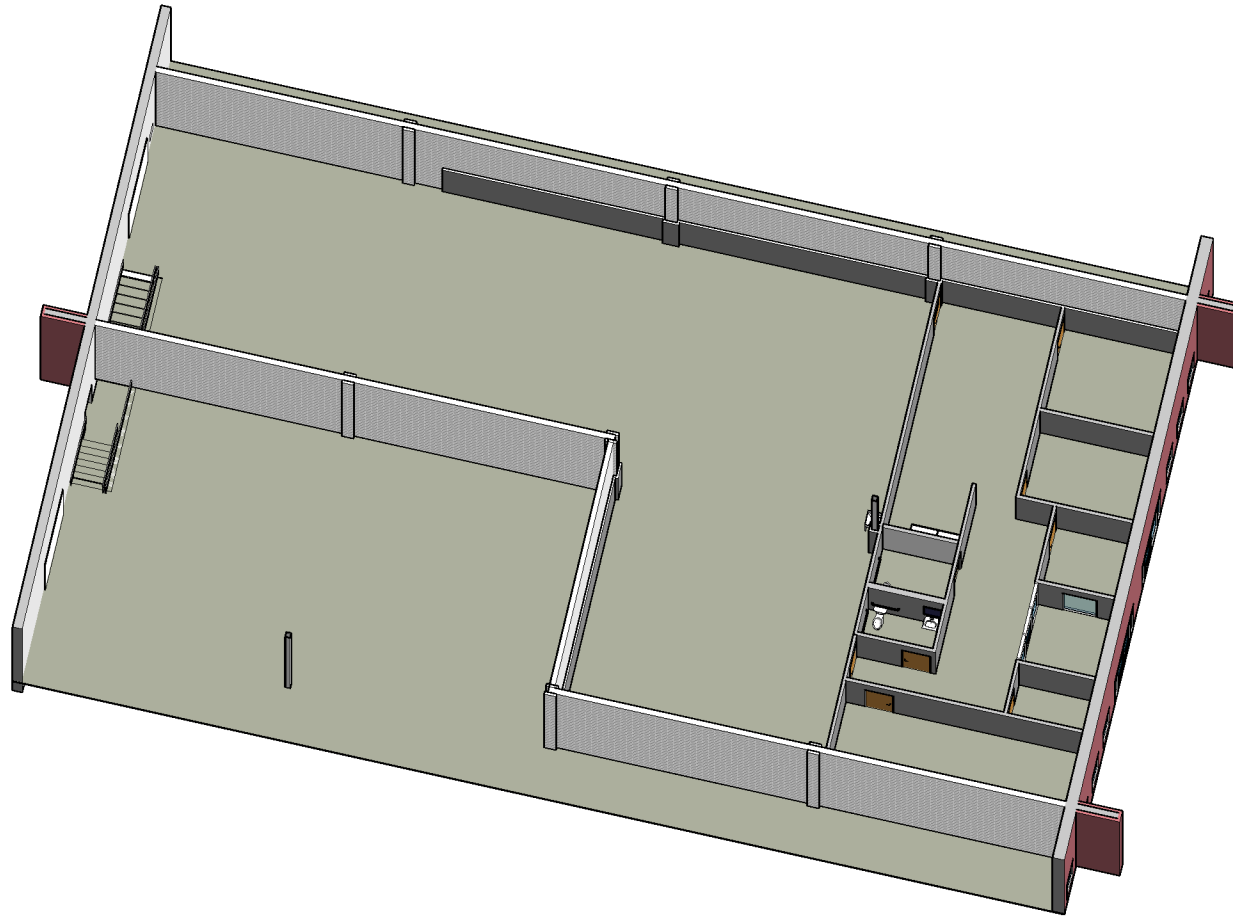

3D VIEW