


TOTAL SF AVAILABLE - 5,400 SF


OFFICE - 5,400 SF

WAREHOUSE - 0,000 SF

[Click to access 3D model](#)

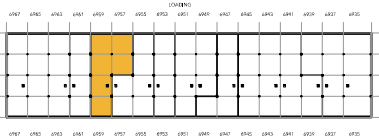

Key Plan

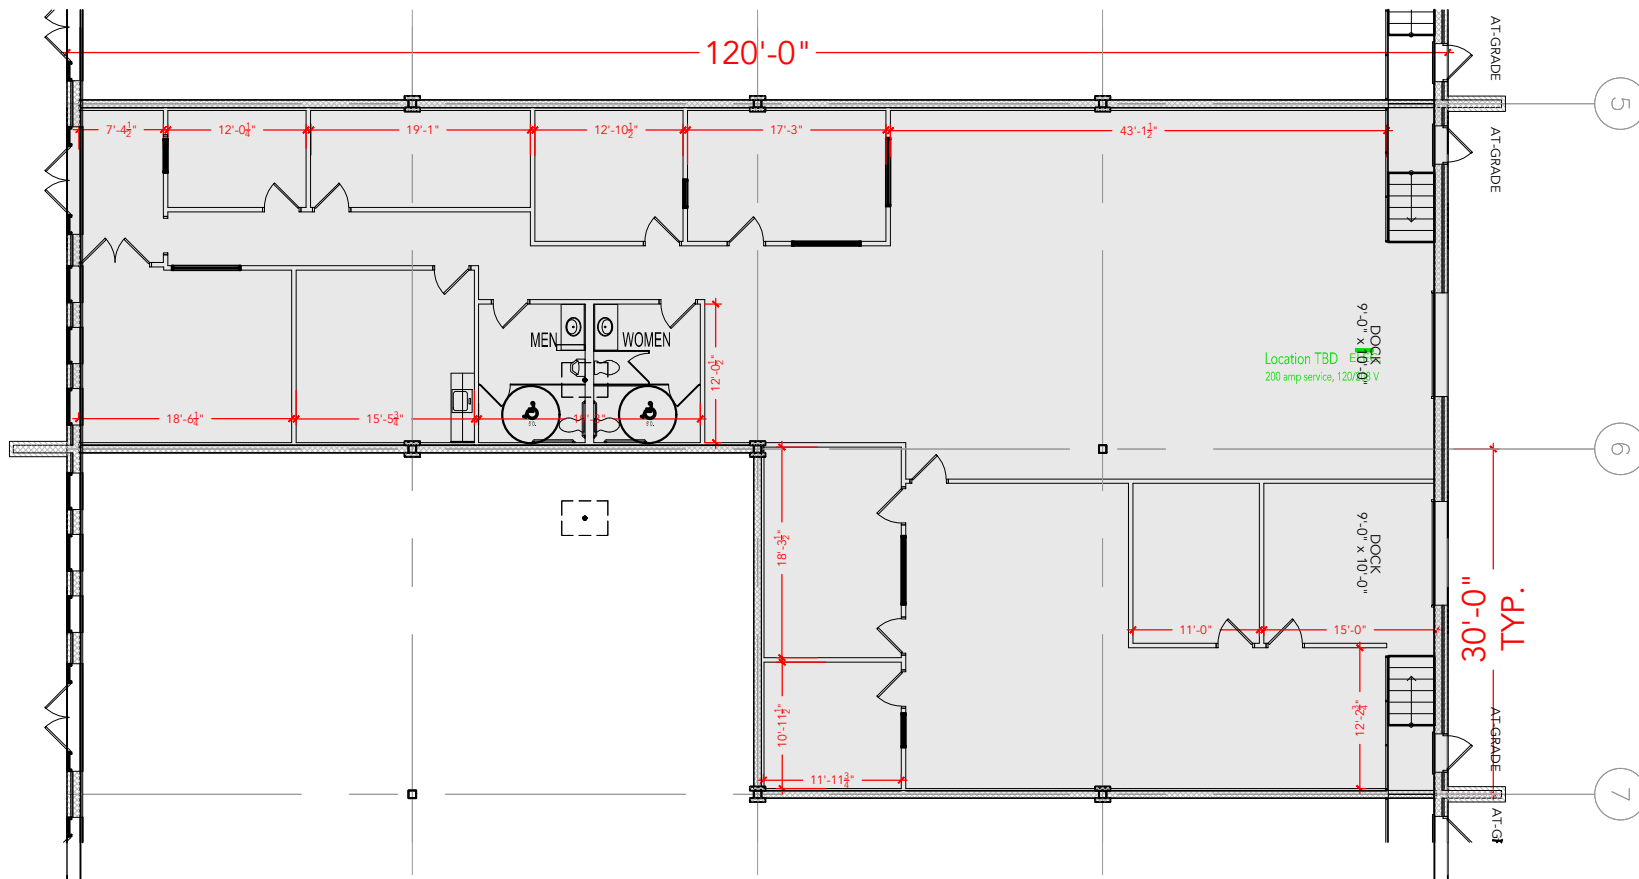

6959
6957
6

Floor Plan