


TOTAL SF AVAILABLE - 10,800 SF


OFFICE - 3,043 SF

WAREHOUSE SF - 7,757 SF

[Click to access 3D model](#)

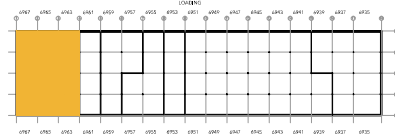

Key Plan

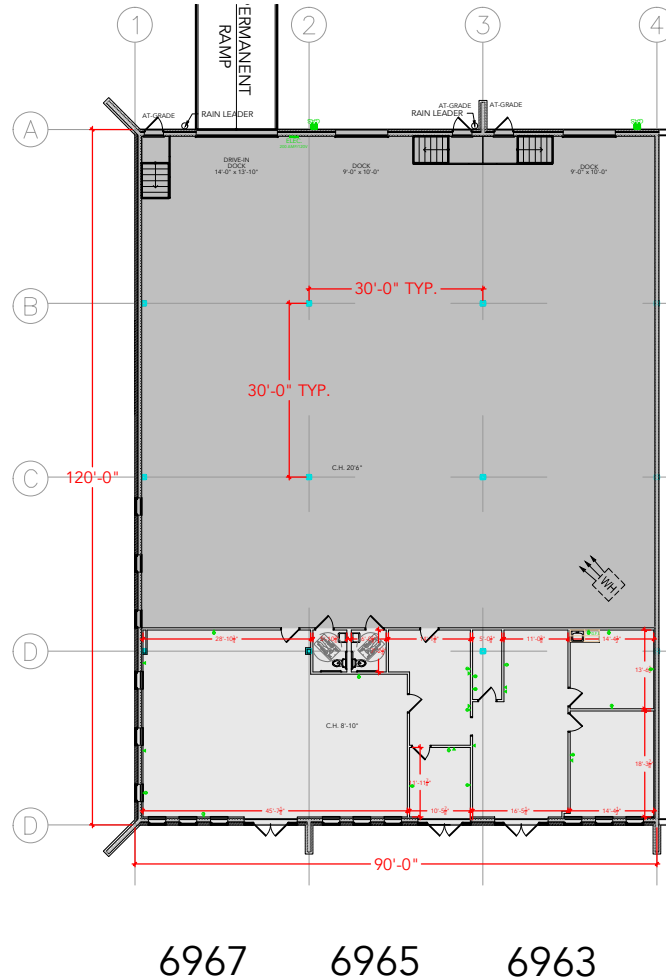

Floor Plan