



TOTAL SF AVAILABLE -6,471 RSF (9%)

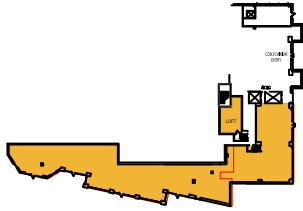

Key Plan

[Click to access 3D model](#)

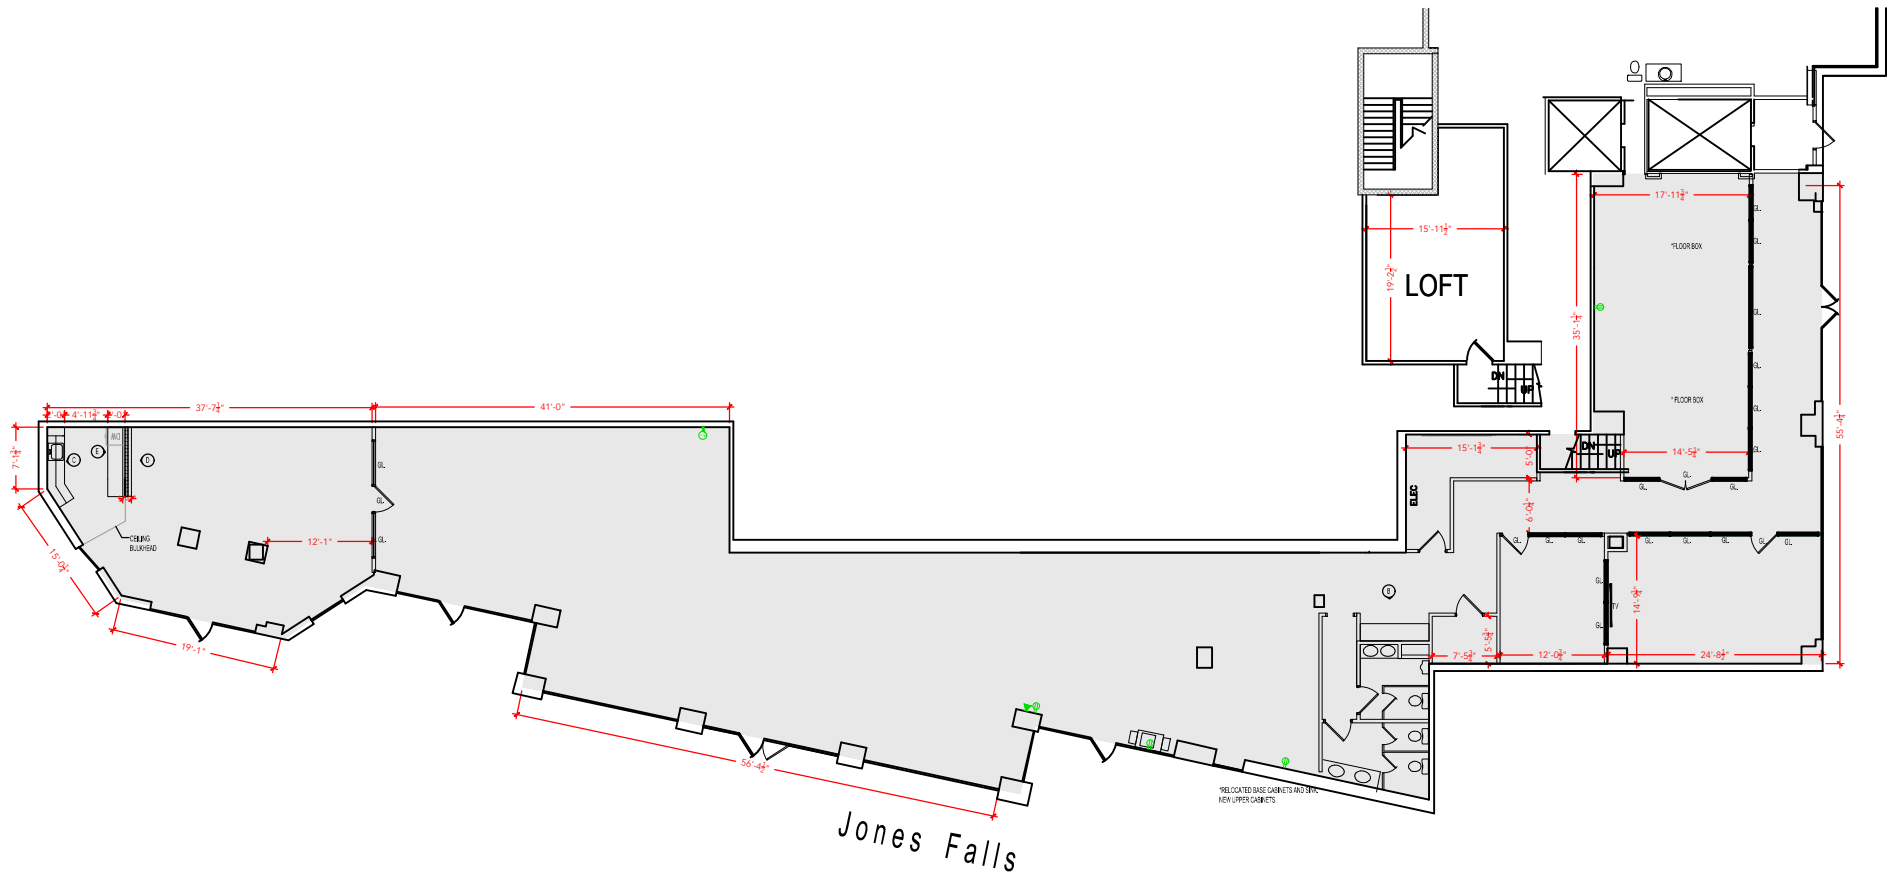

## Floor Plan