



TOTAL SF AVAILABLE - 6,064 RSF(12%)

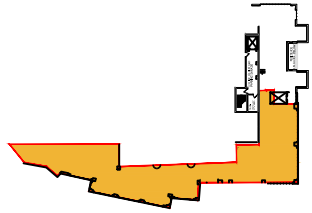

Key Plan

[Click to access 3D model](#)

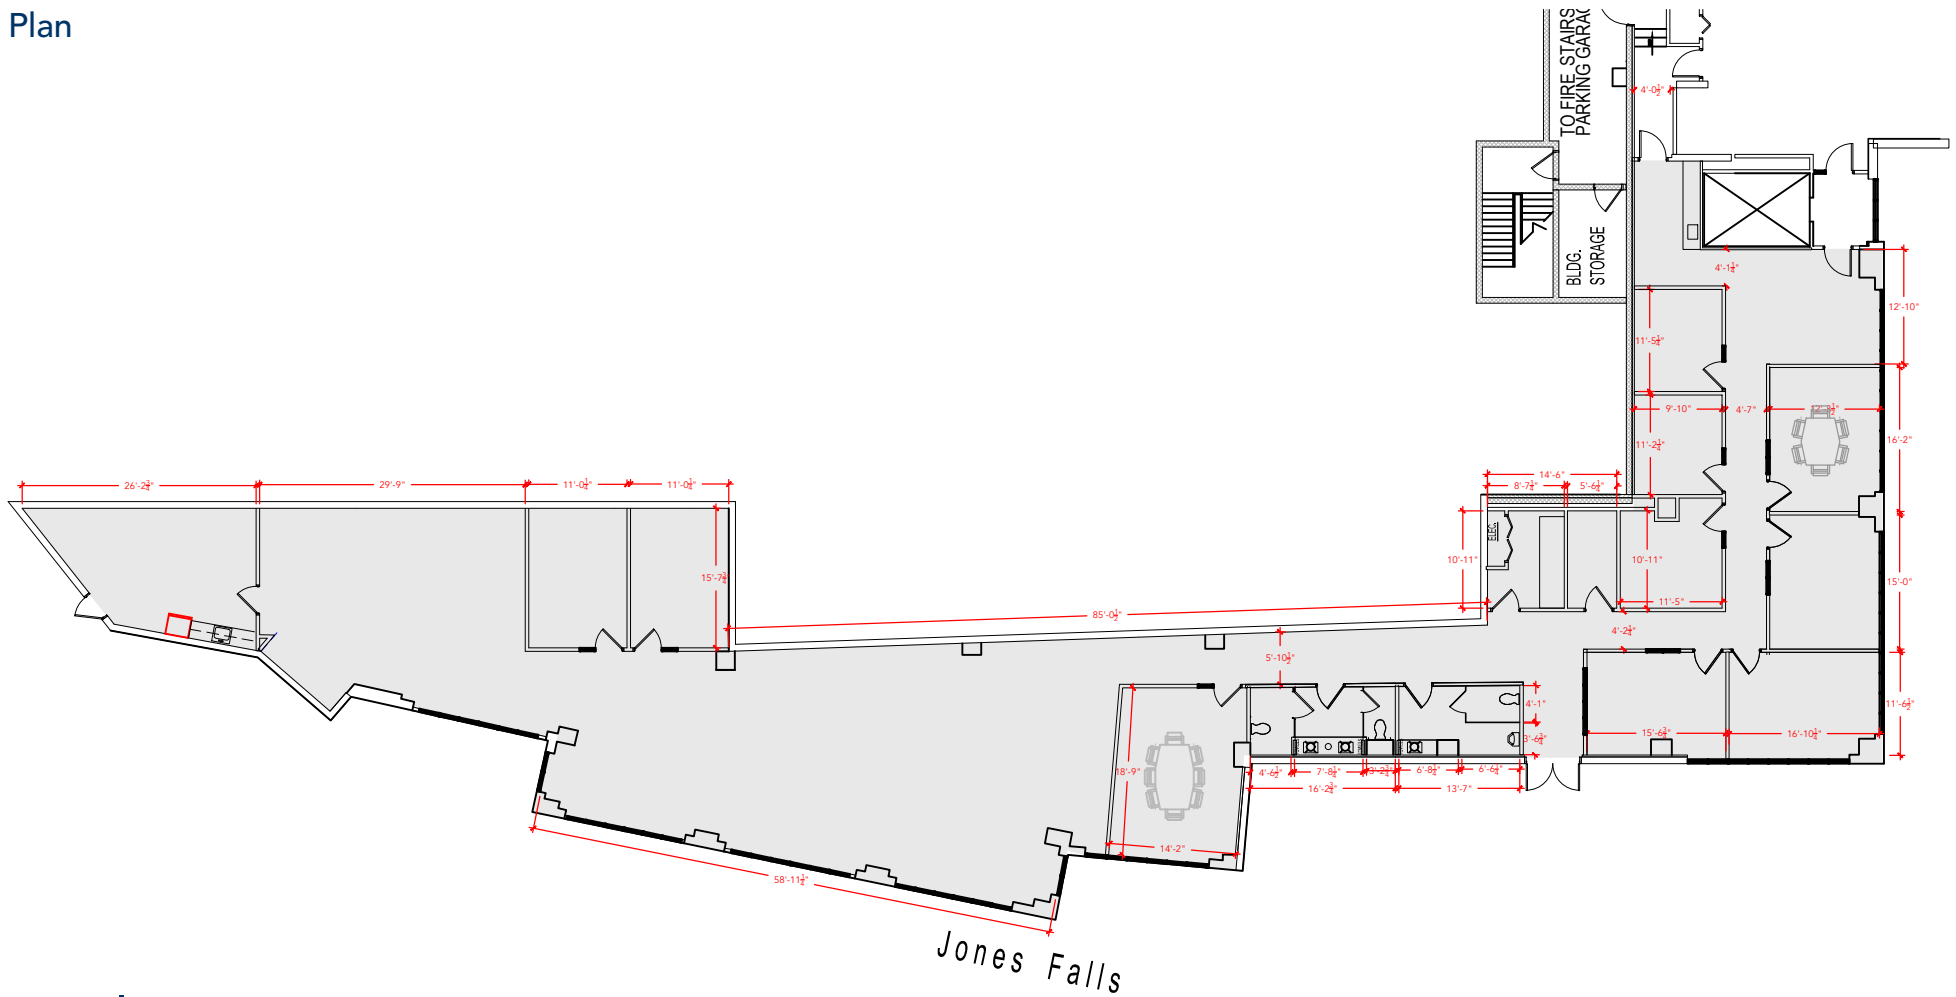

Floor Plan