



**TOTAL SF AVAILABLE -1,440 RSF (12%)**

[Click to access CADD file](#)

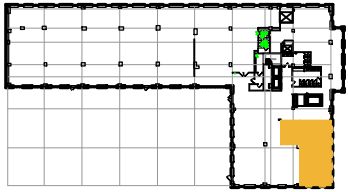

**Key Plan**

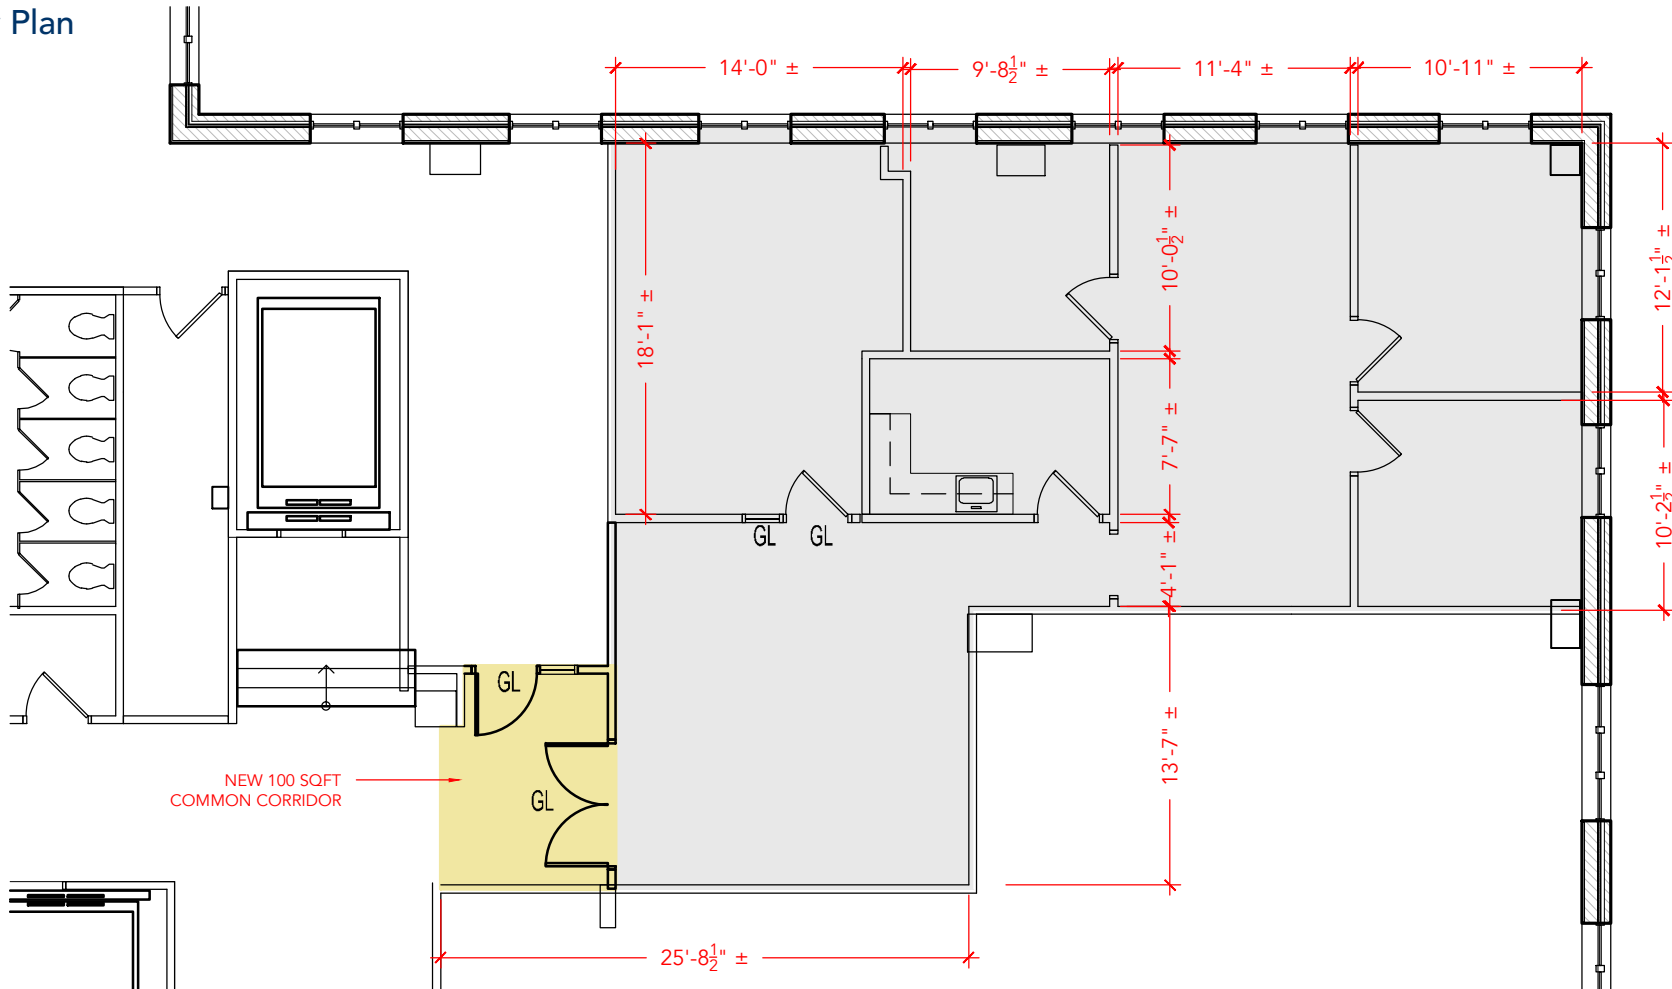

**Floor Plan**