

Key Plan




**TOTAL SF AVAILABLE - 5,753 RSF**

**MEZZ USF 1,330 USF**

**GROUND LEVEL 4,423 USF**

*3,256 USF ON LOWER LEVEL NOT INCLUDED IN TOTALS*

[Click to access 3D model](#)

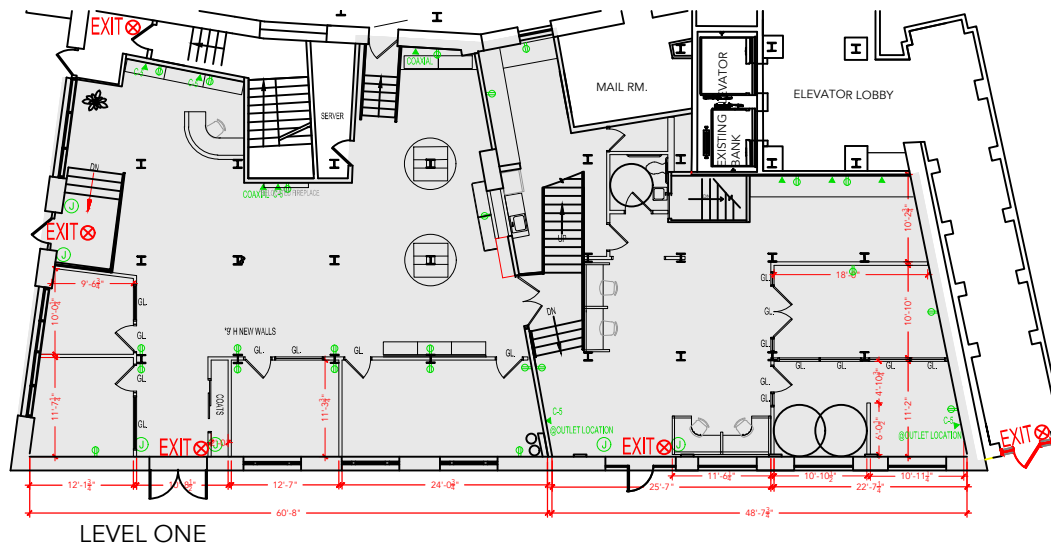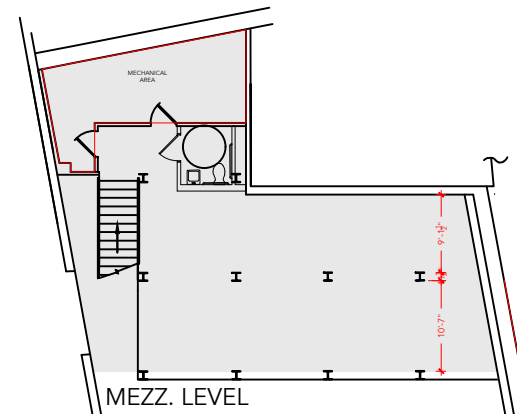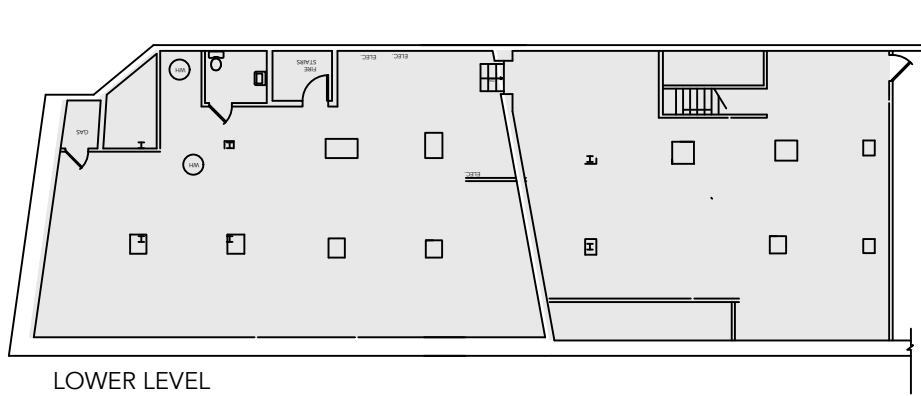

## Floor Plan