



TOTAL SF AVAILABLE - 8,075 RSF (9%)

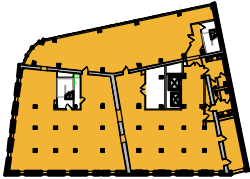

[Click to access 3D model](#)

Key Plan

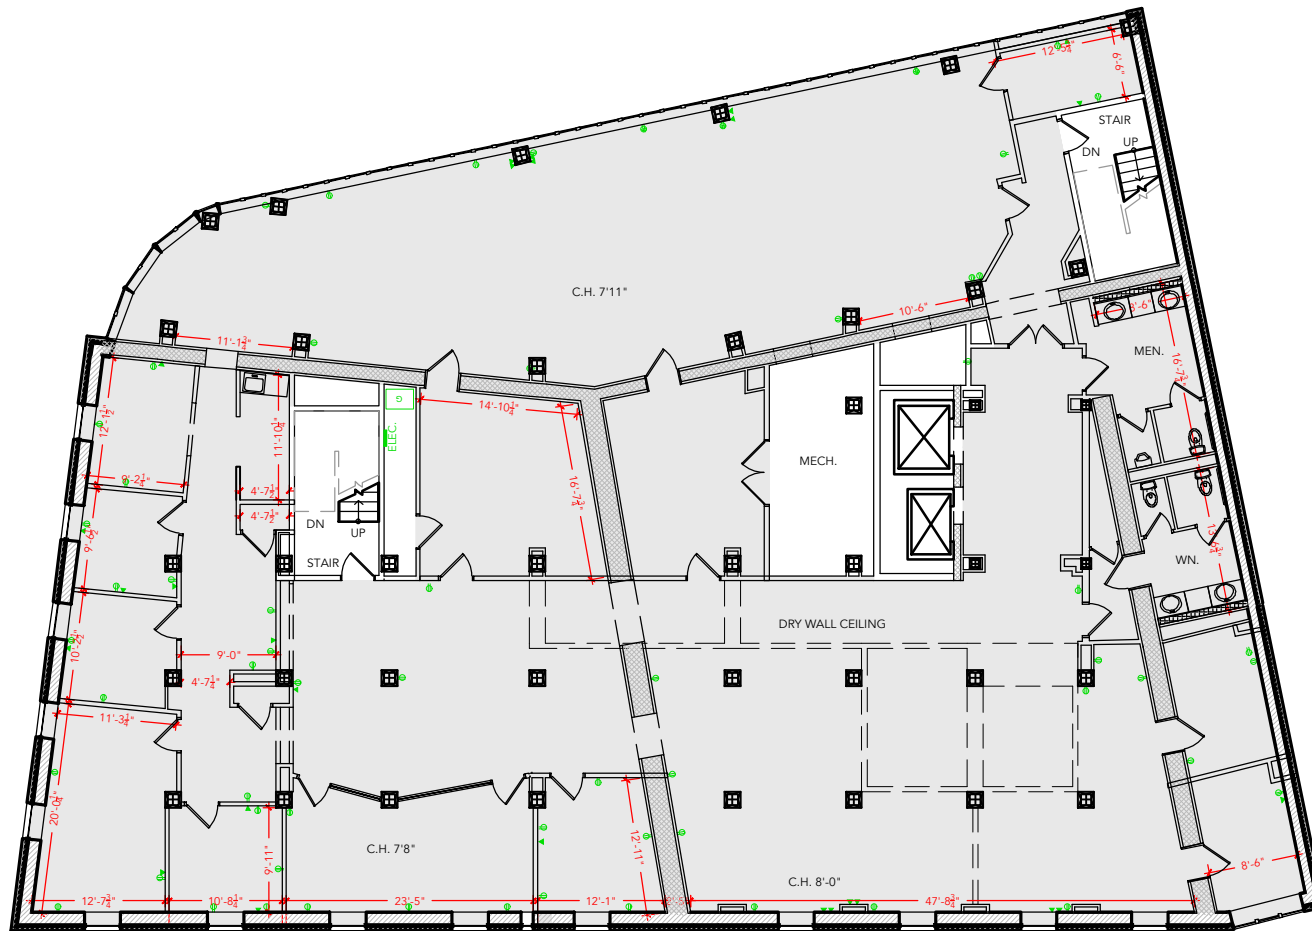

Floor Plan