



TOTAL SF AVAILABLE - 8,075 RSF (9%)

[Click to access 3D model](#)

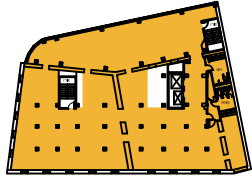

Key Plan

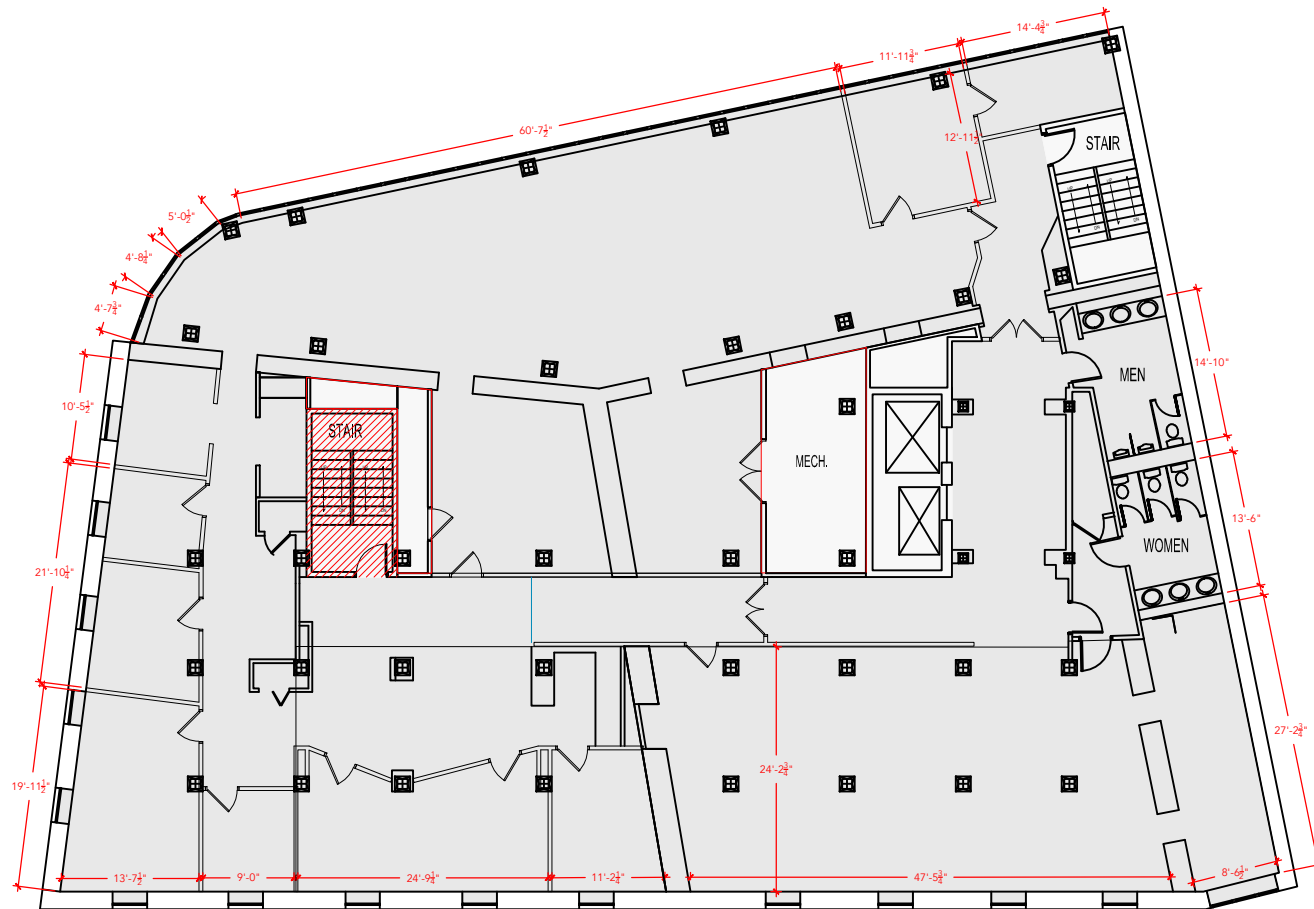

Floor Plan