



TOTAL SF AVAILABLE -5,114 RSF (12%)

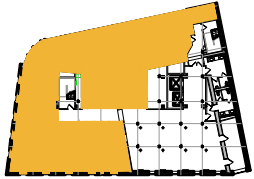

[Click to access 3D model](#)

Key Plan

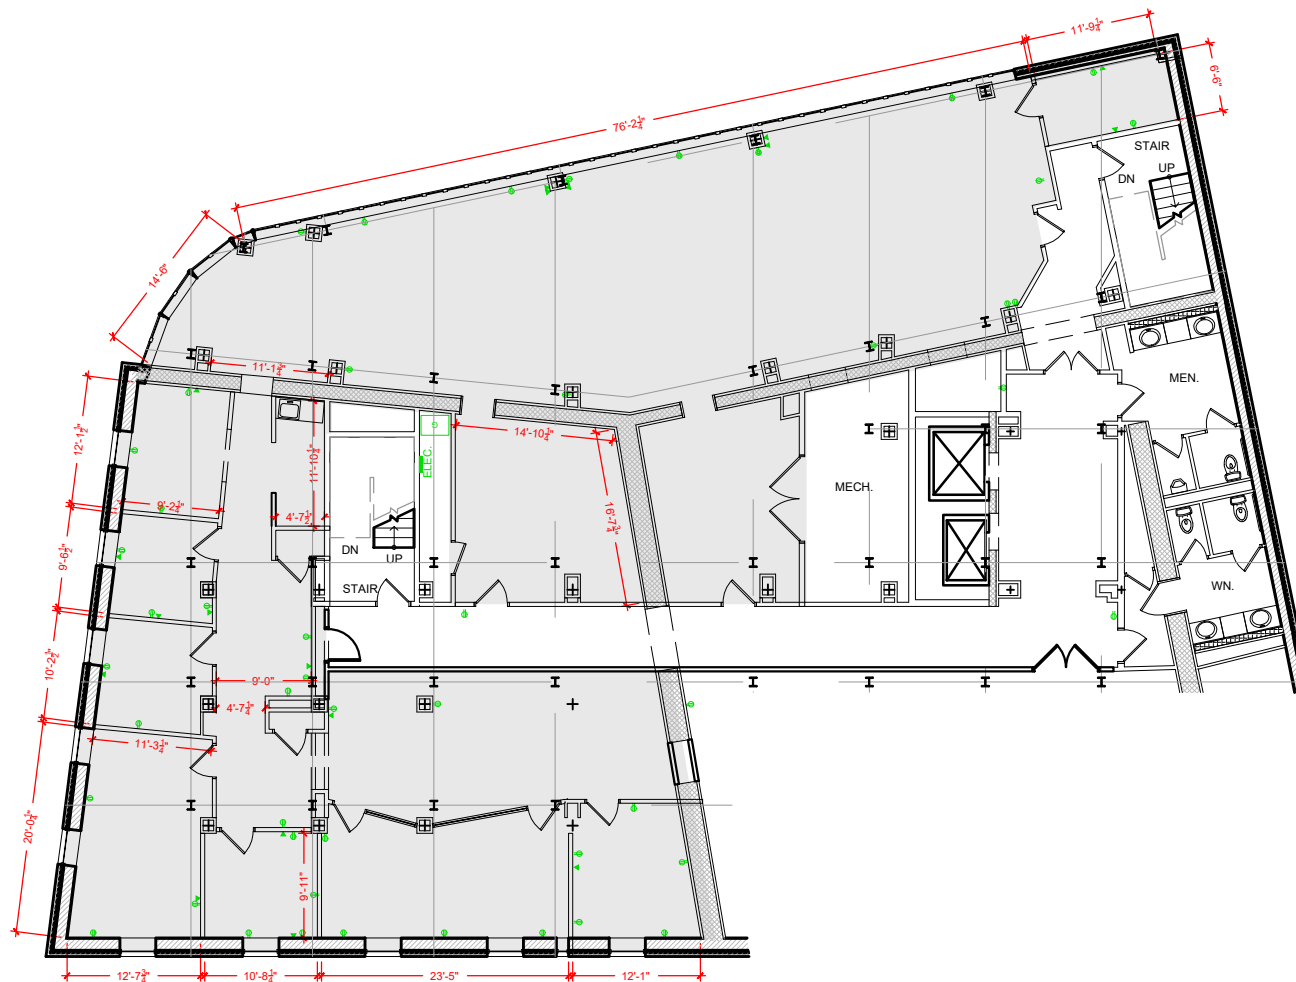

Floor Plan