



TOTAL SF AVAILABLE - 2,809 RSF

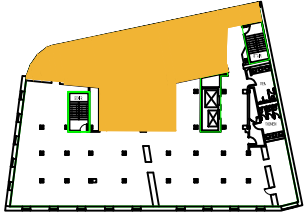

Key Plan

[Click to access 3D model](#)

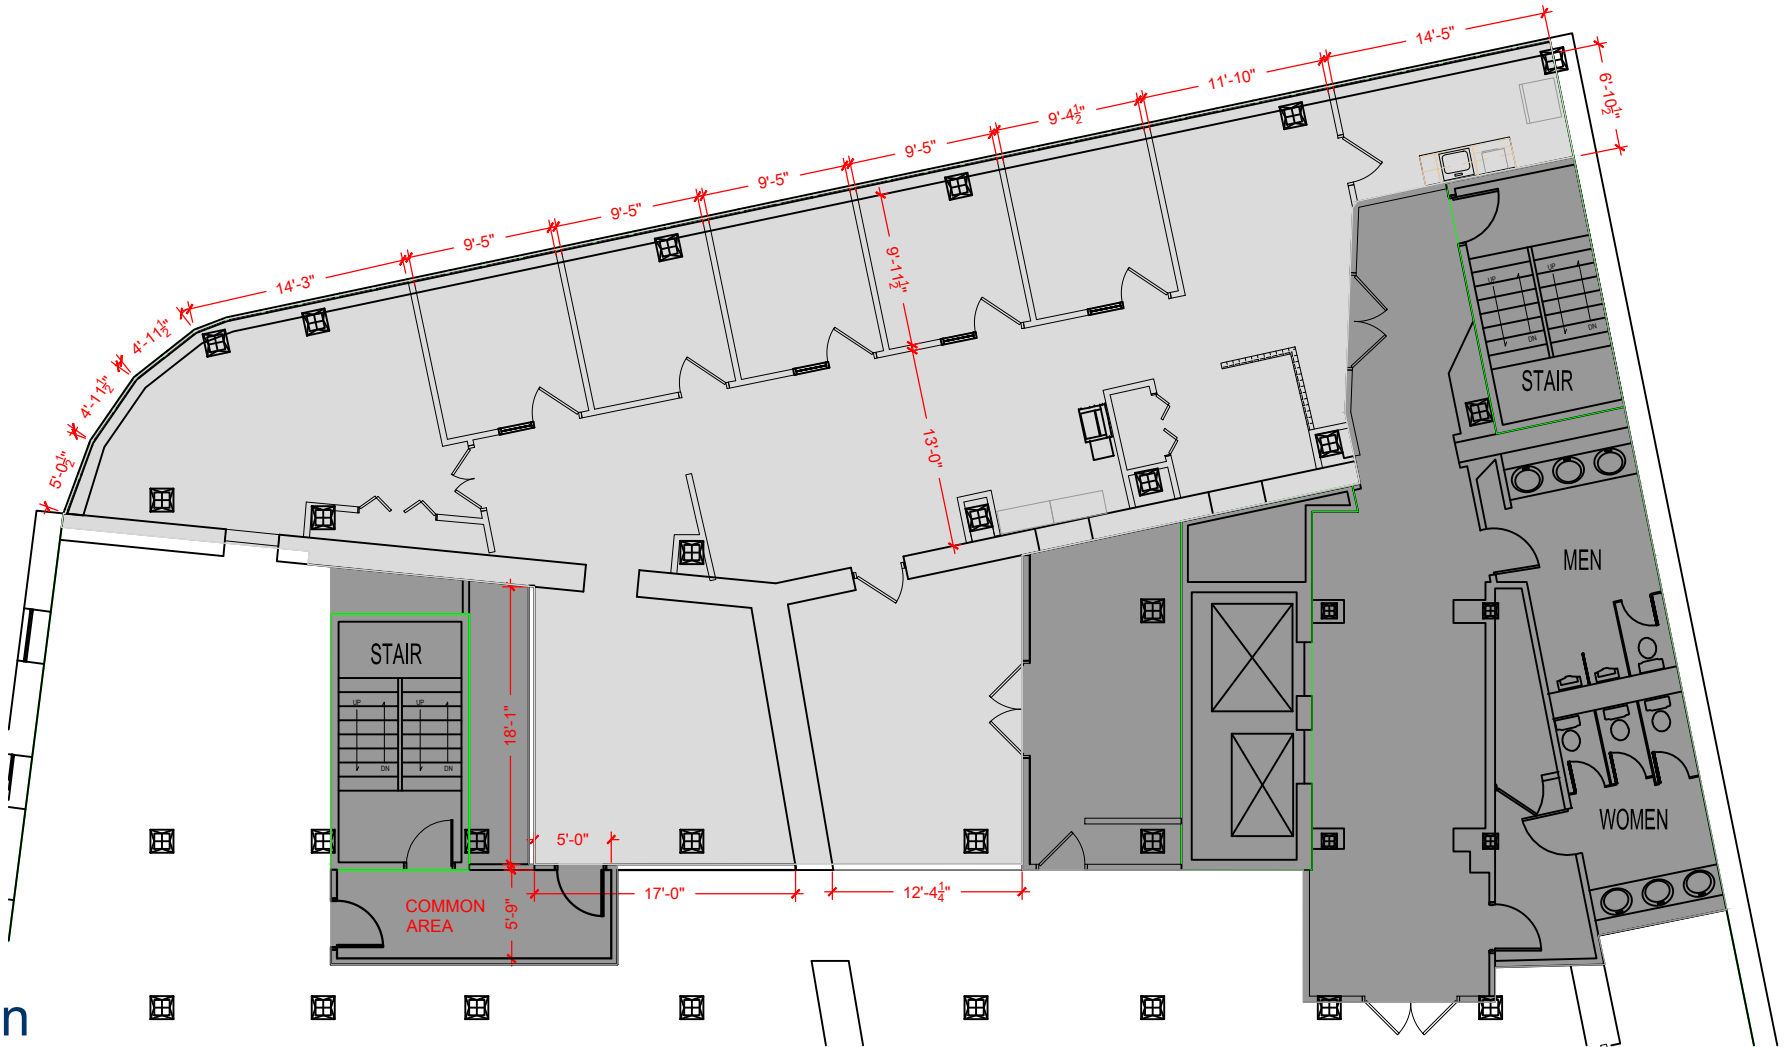

Floor Plan