
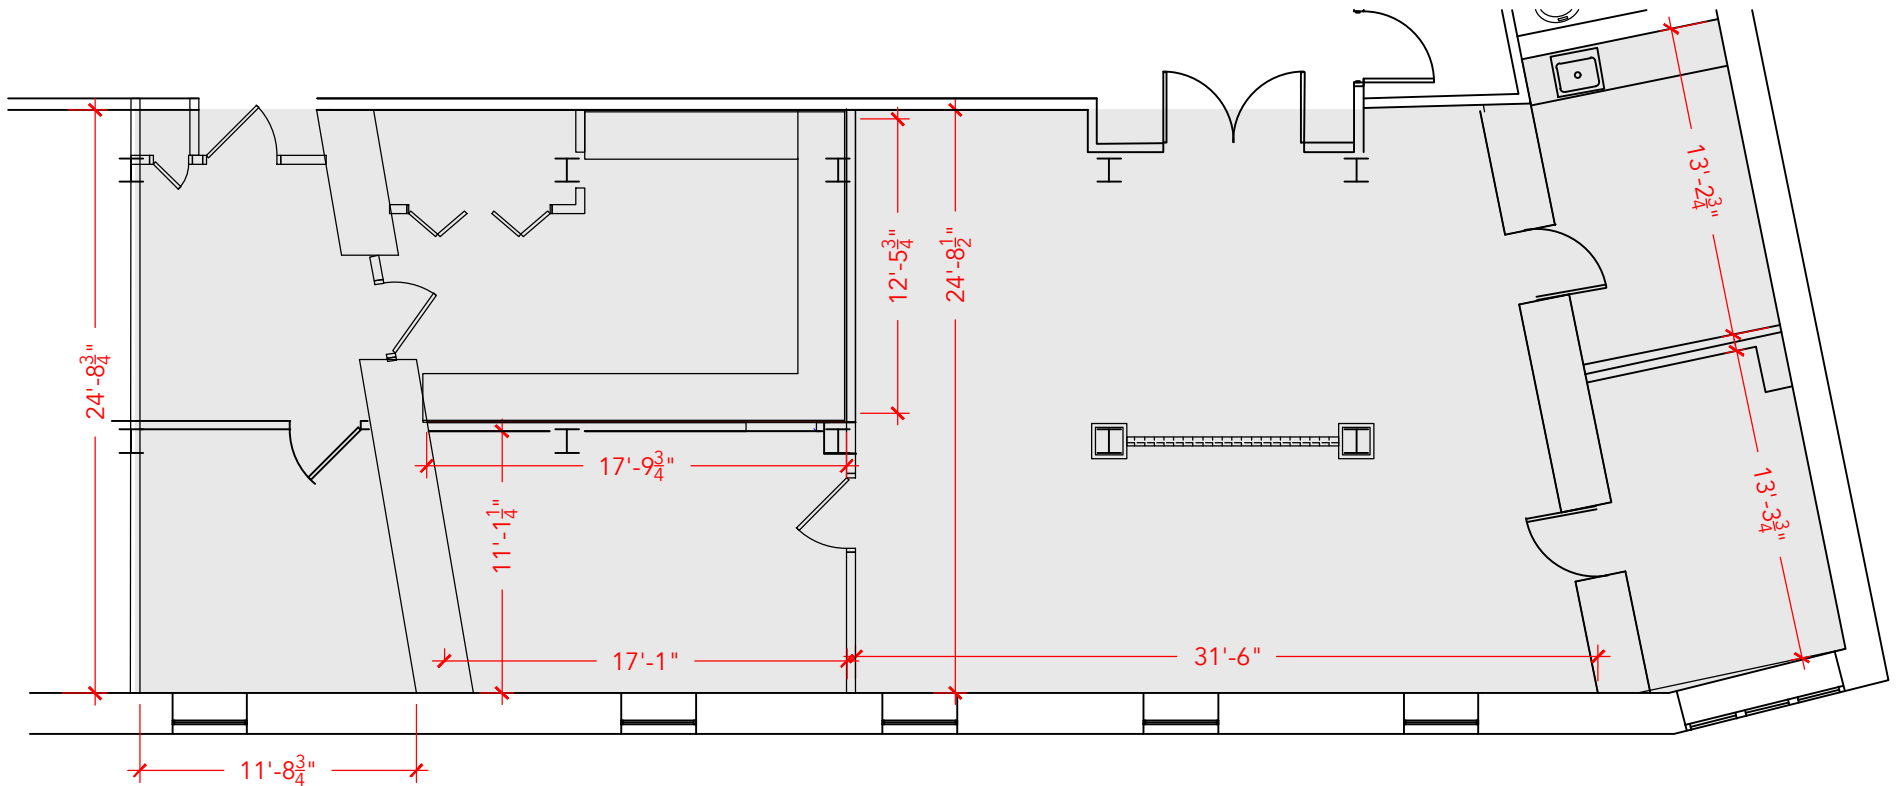


TOTAL SF AVAILABLE - 1,972 RSF (12%)

[Click to access 3D model](#)

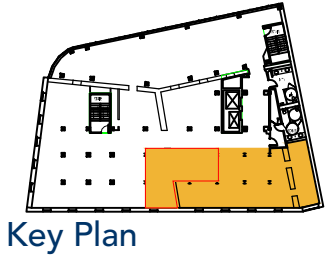

## Floor Plan