



TOTAL SF AVAILABLE - 8,127 RSF (9%)

[Click to access 3D model](#)

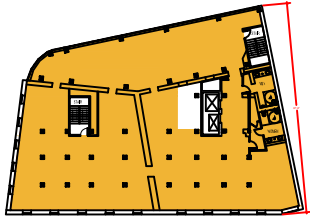

Key Plan

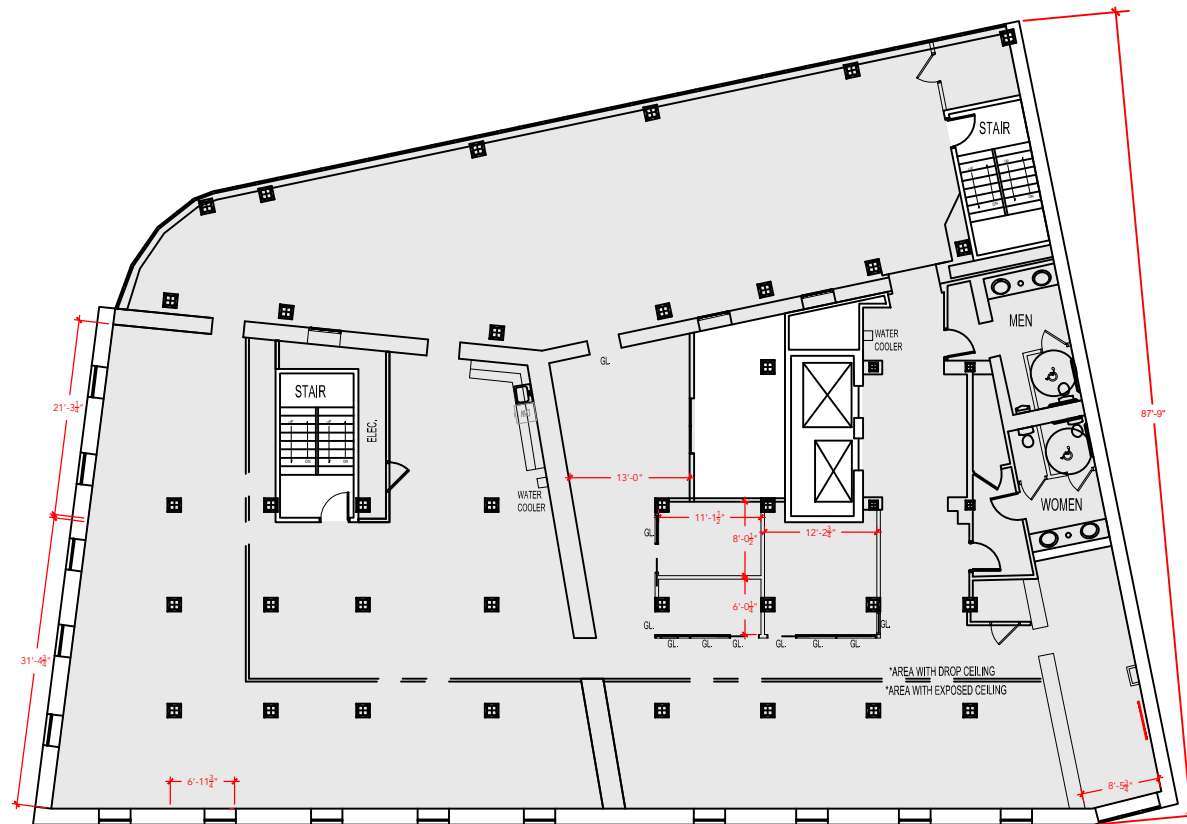

LEVEL SIX

Floor Plan