




[Click to access CADD file](#)

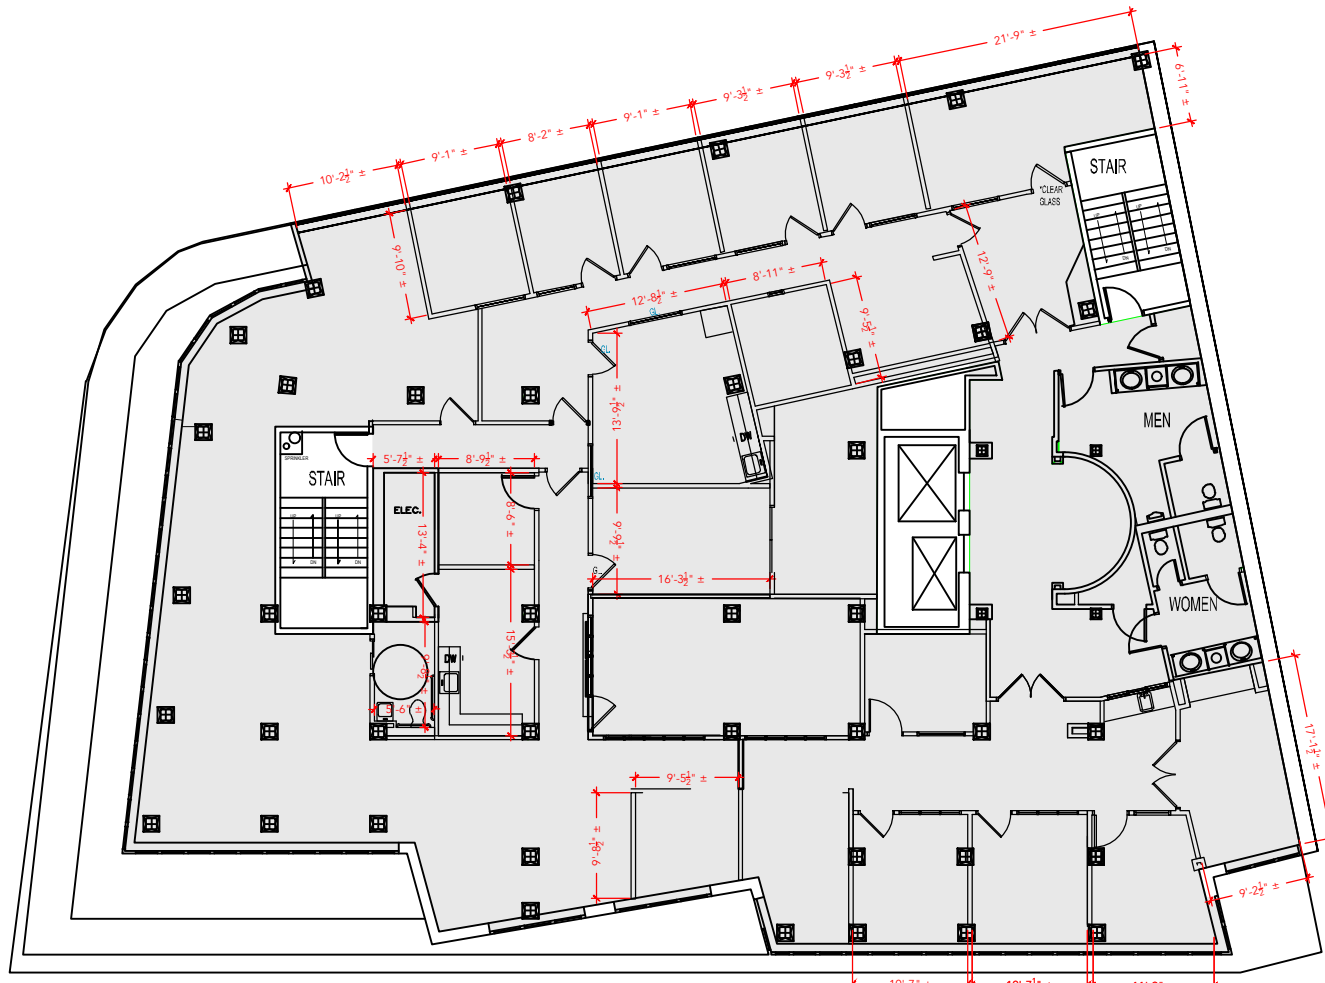

Floor Plan

ASBUILT DATE: NEEDS TO BE