



TOTAL SF AVAILABLE - 6,900 RSF(12%)

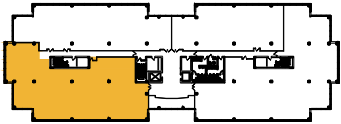

[Click to access 3D model](#)

Key Plan

SUITE 345
765 RSF (12%)

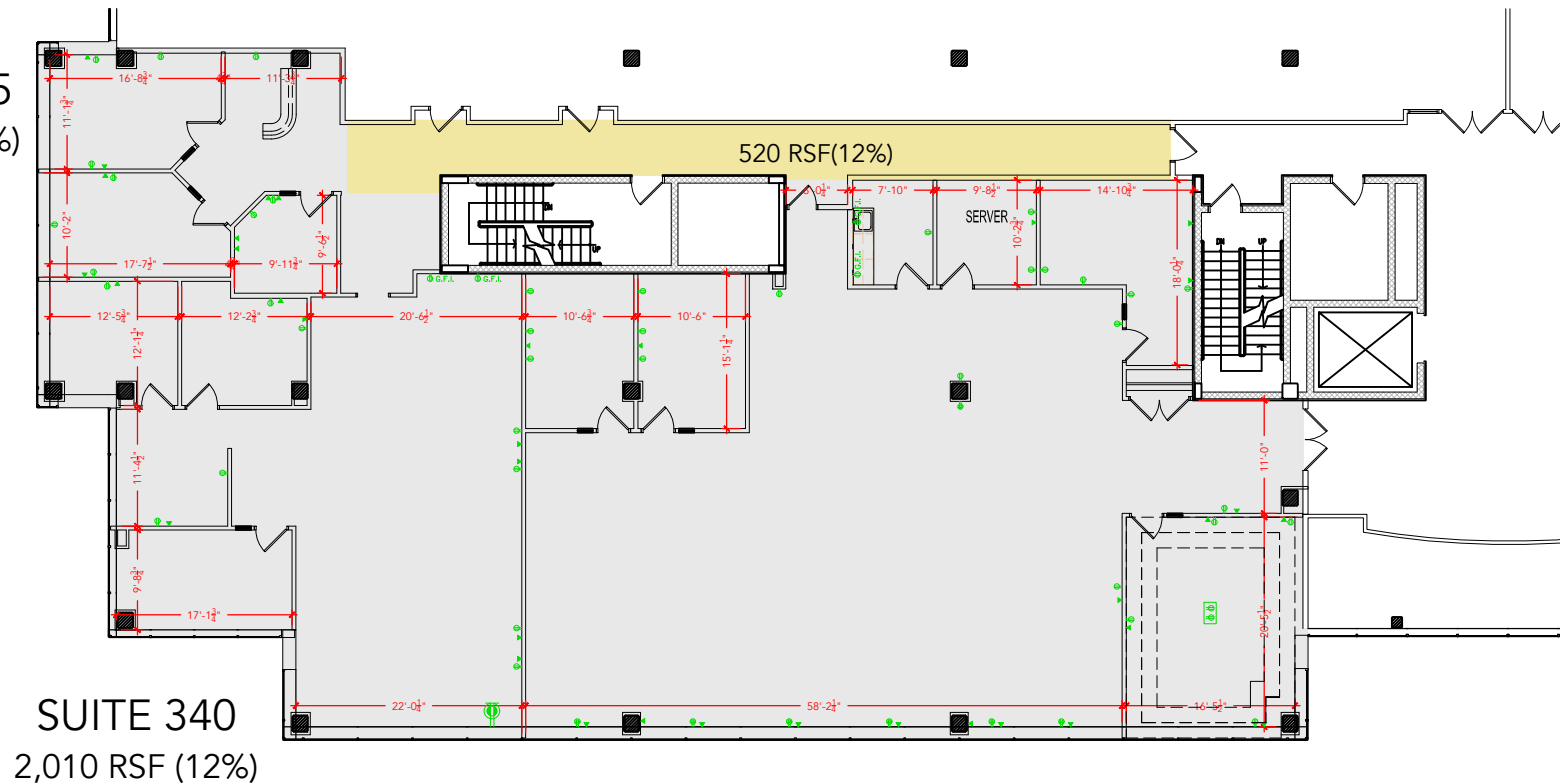

Floor Plan