



TOTAL SF AVAILABLE - 2,010 RSF(12%)

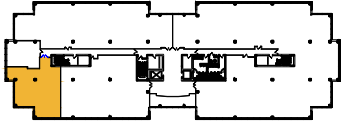

Key Plan

[Click to access 3D model](#)

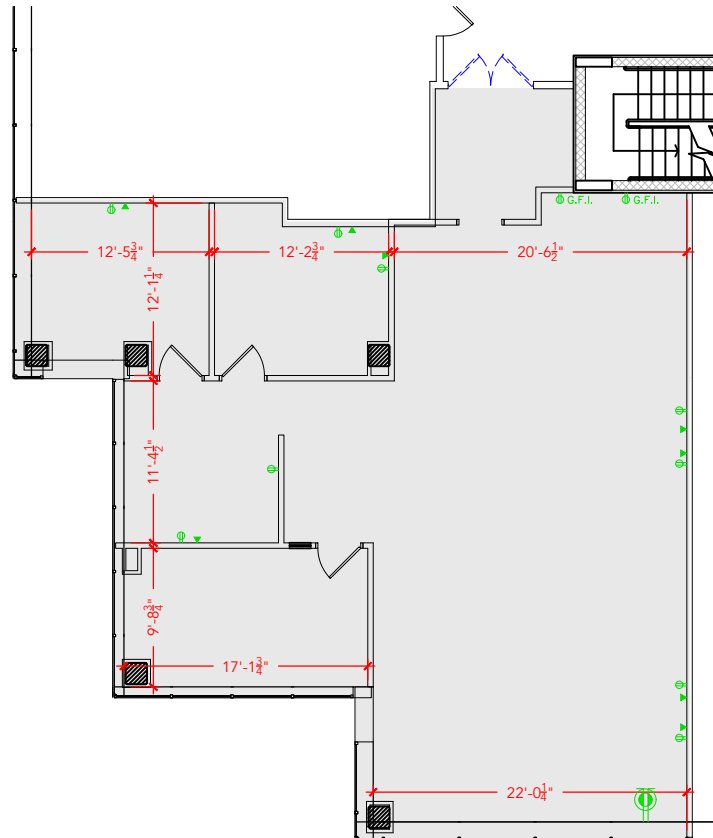

Floor Plan