



TOTAL SF AVAILABLE - 5,009 RSF(16%)

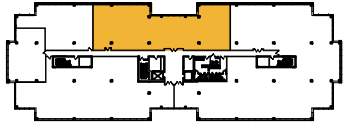

[Click to access 3D model](#)

## Key Plan

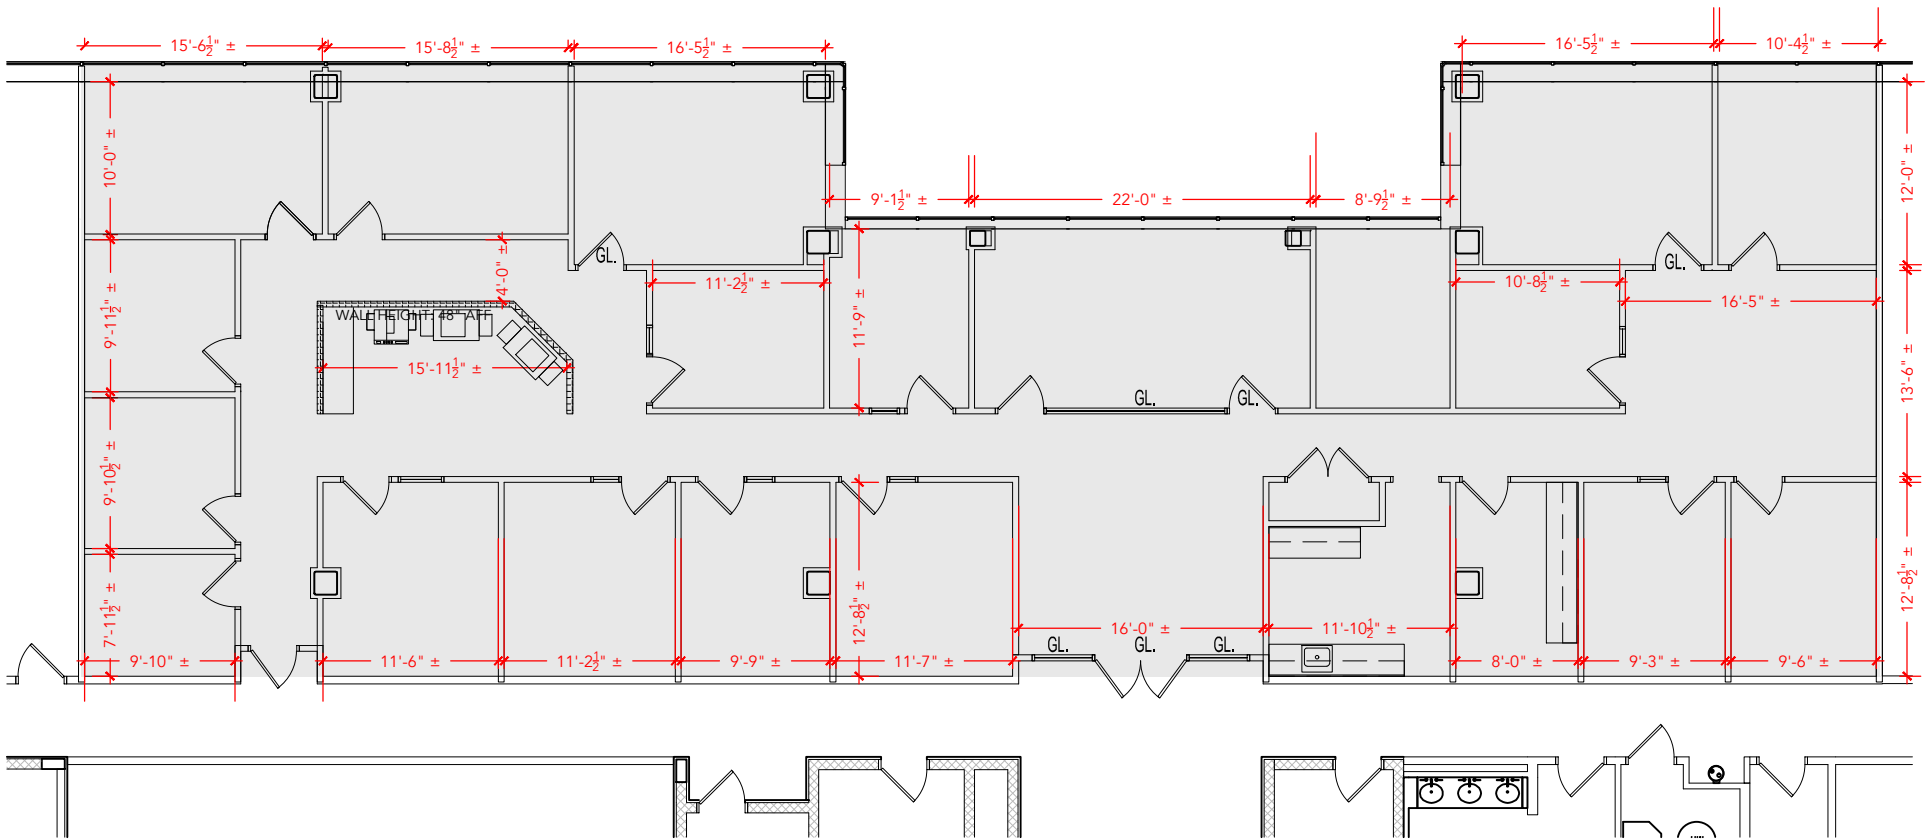

## Floor Plan