


TOTAL SF AVAILABLE - 8,098 RSF(16%)



[Click to access 3D model](#)

## Key Plan

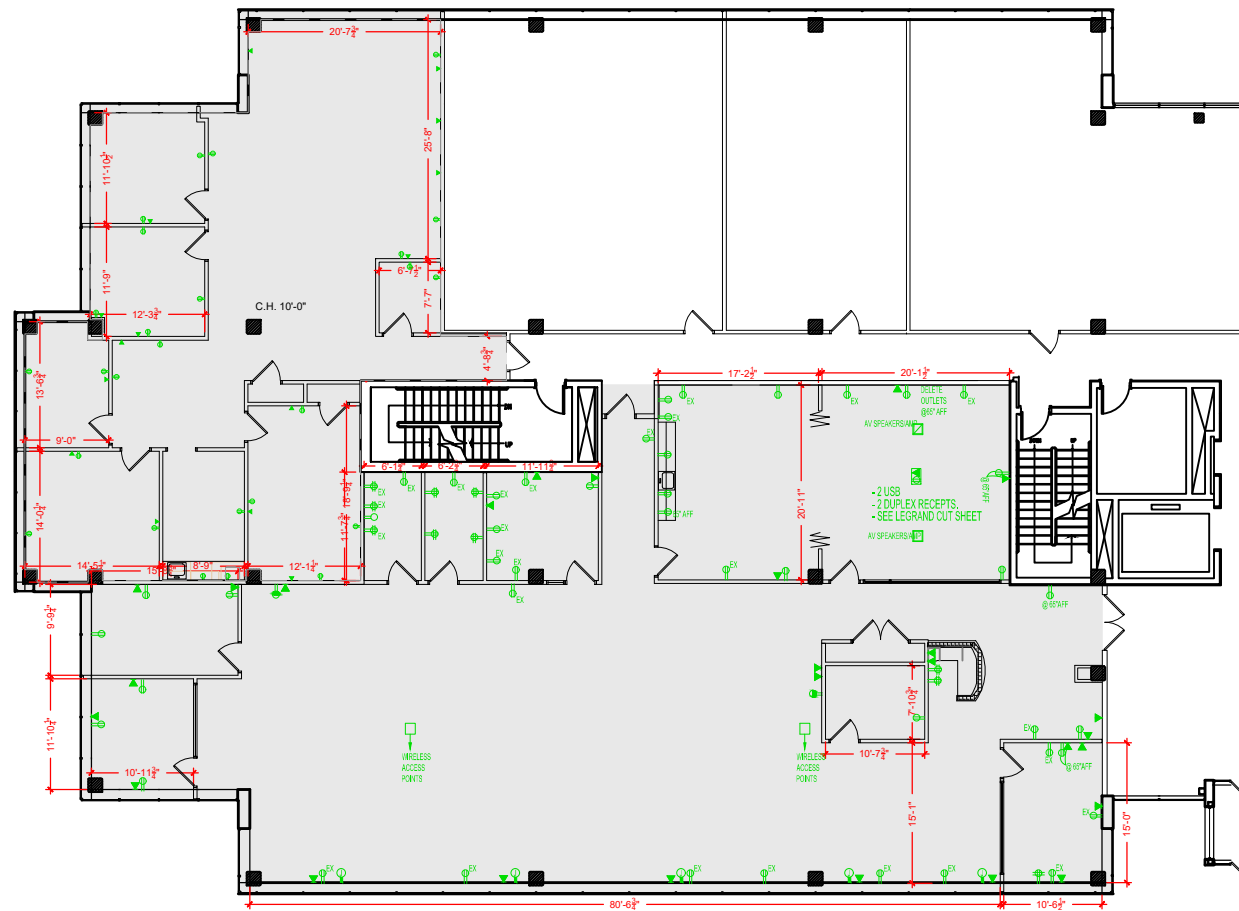

## Floor Plan