


TOTAL SF AVAILABLE - 2,619 RSF (16%)



[Click to access 3D model](#)

Key Plan

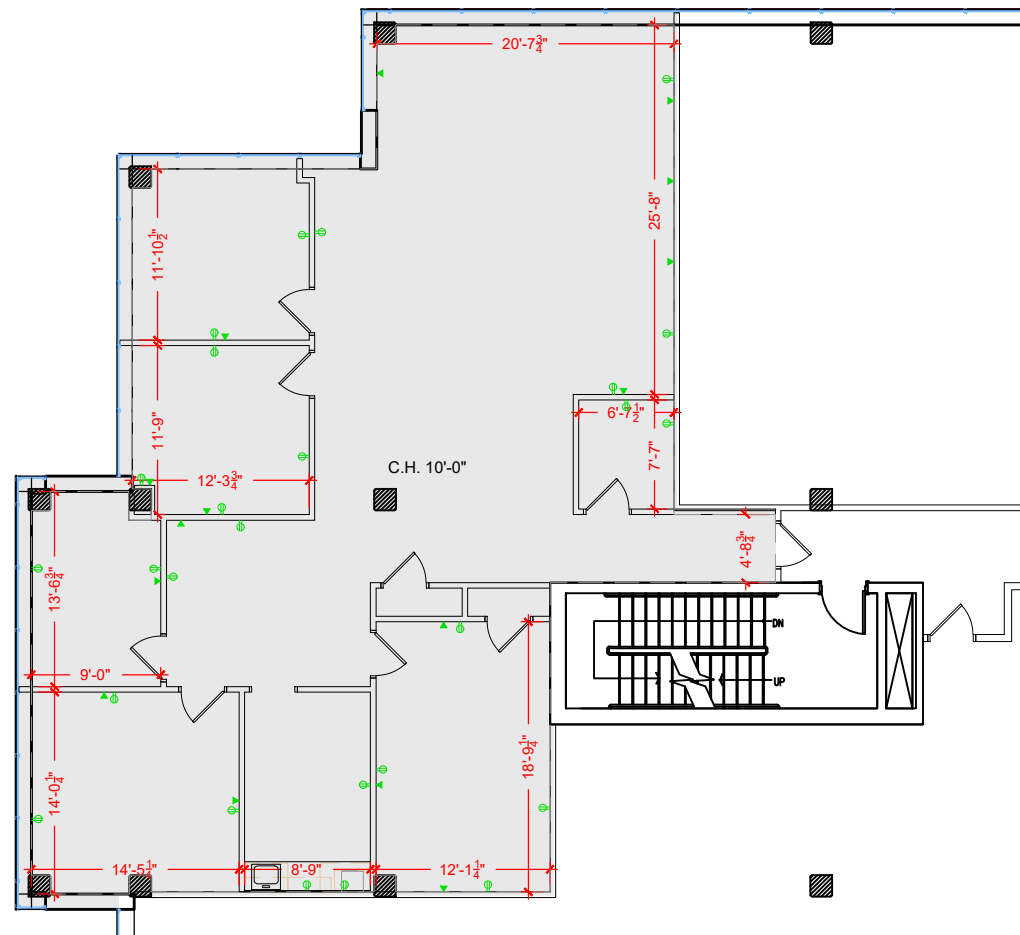

Floor Plan