


TOTAL SF AVAILABLE -1,005 RSF (12%)



Key Plan

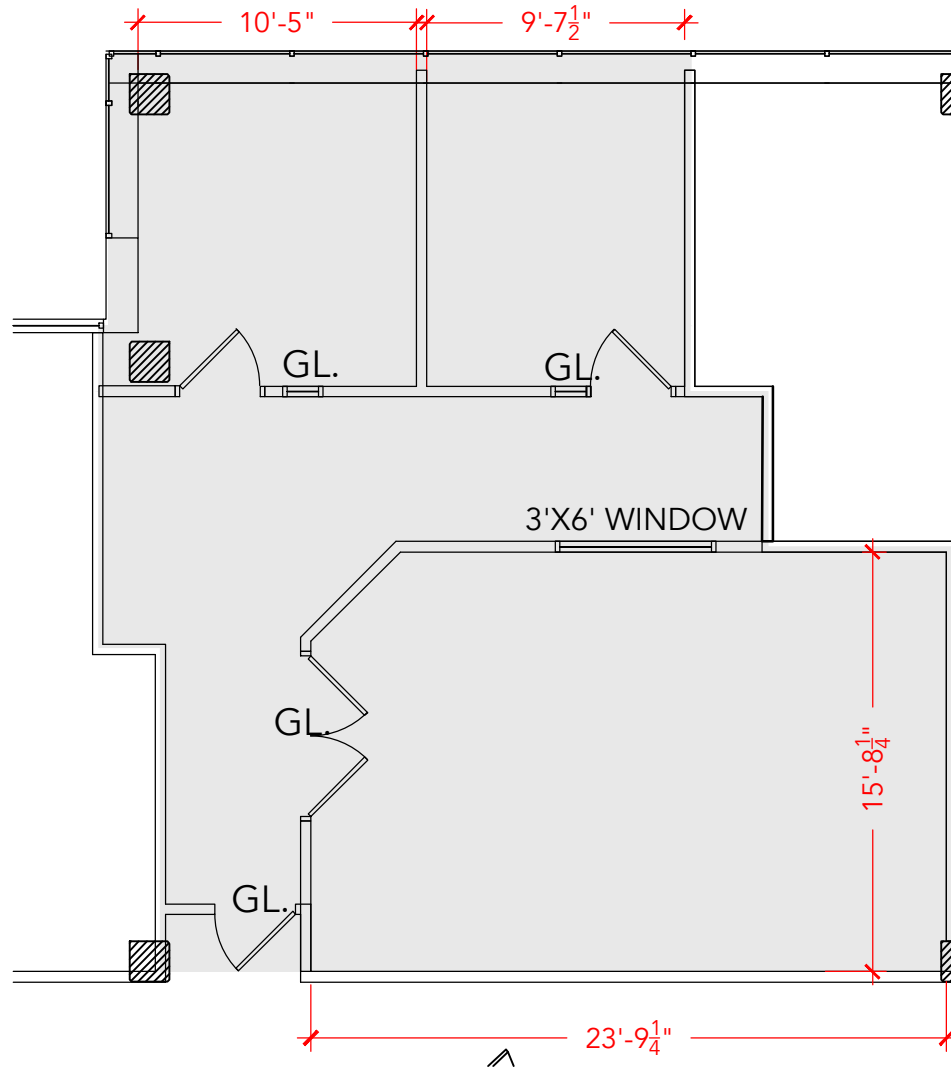

[Click to access 3D model](#)

Floor Plan