


TOTAL SF AVAILABLE -1,044 RSF(16%)



Key Plan

[Click to access CADD file](#)

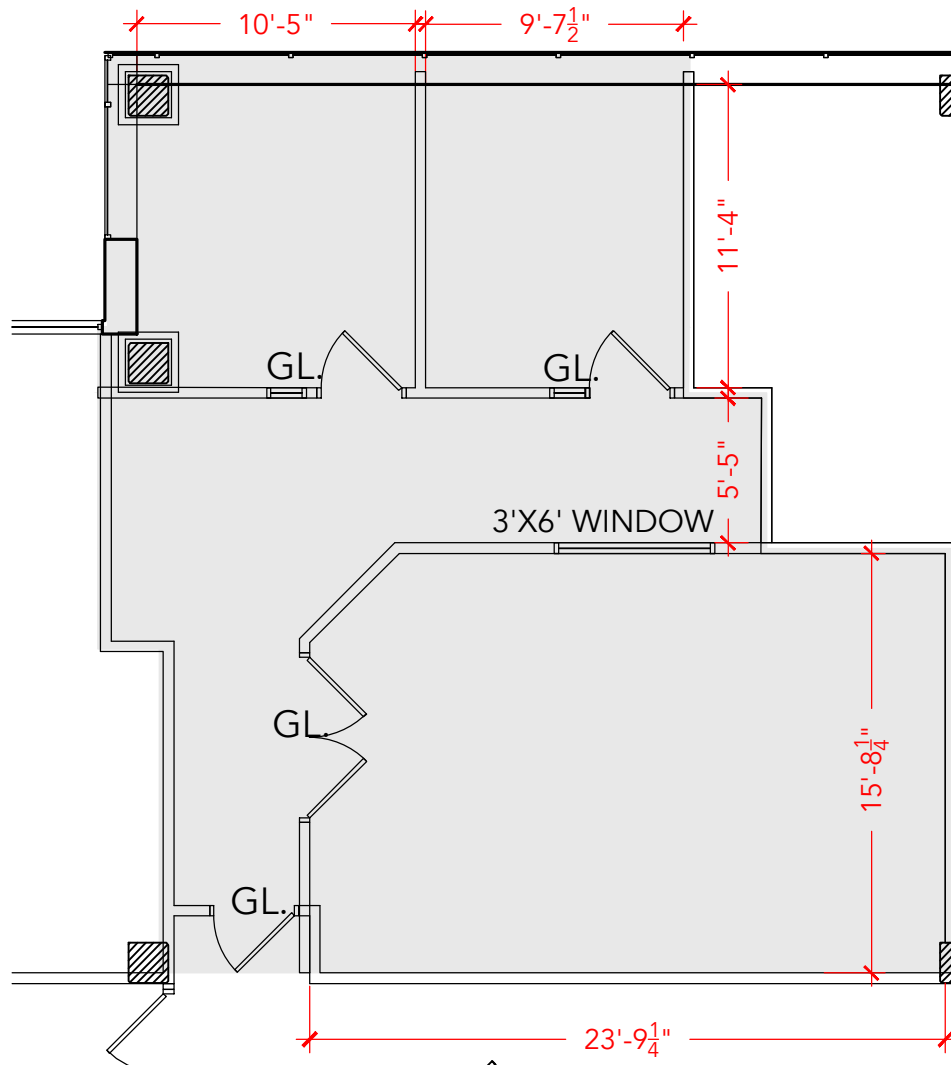

Floor Plan