



TOTAL SF AVAILABLE -8,098 RSF (16%)

[Click to access 3D model](#)

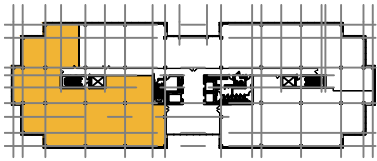

Key Plan

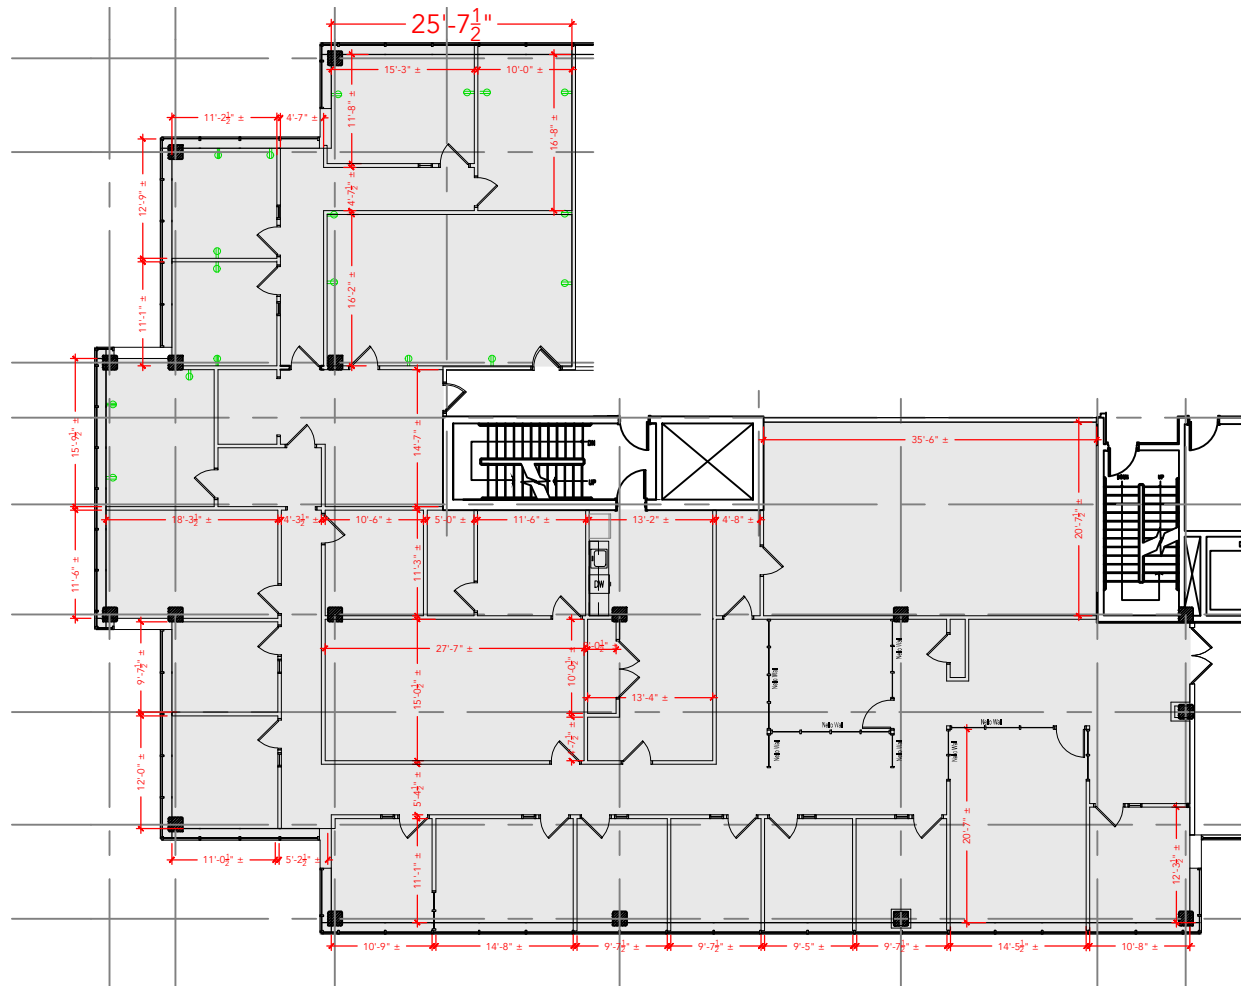

Floor Plan