


Key Plan

TOTAL SF AVAILABLE – 3,428 RSF (16%)

[Click to access CADD file](#)

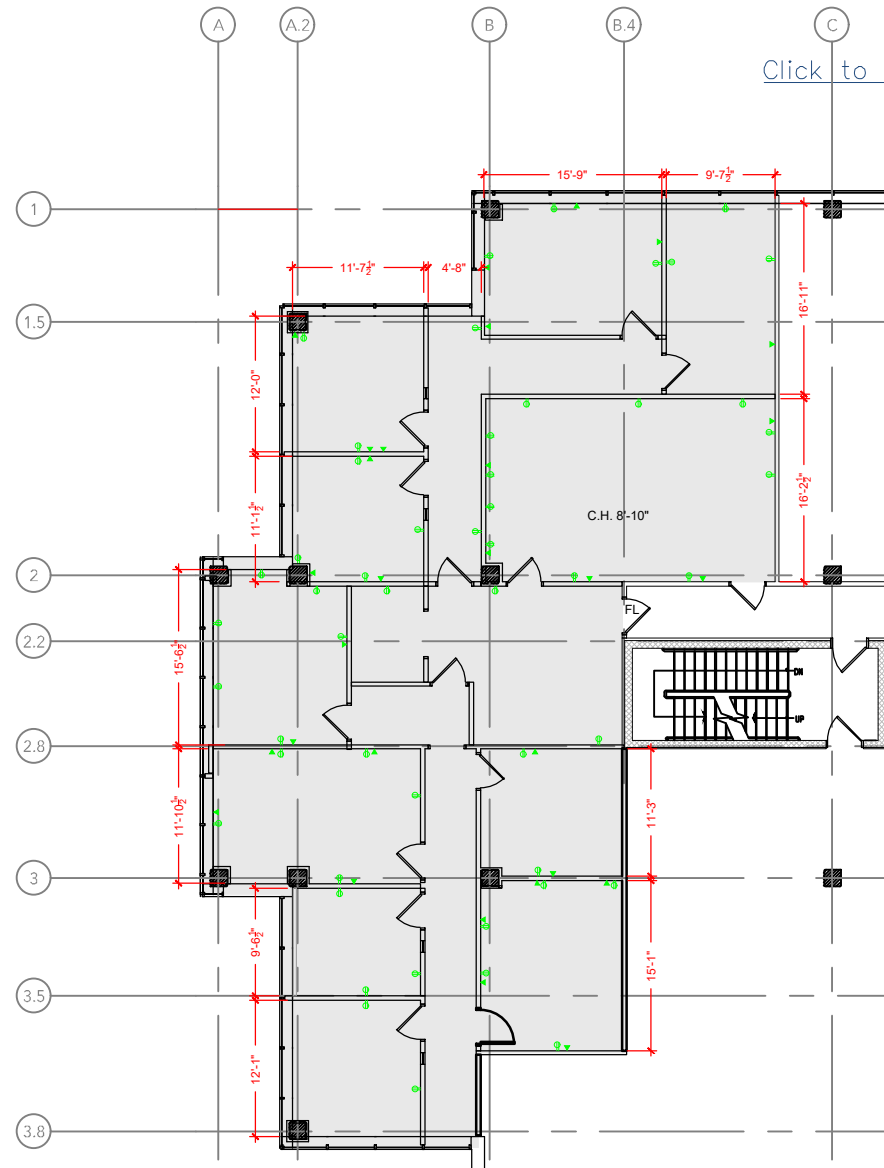

Floor Plan