


TOTAL SF AVAILABLE – 1,557 RSF (16%)

[Click to access CADD file](#)

Key Plan

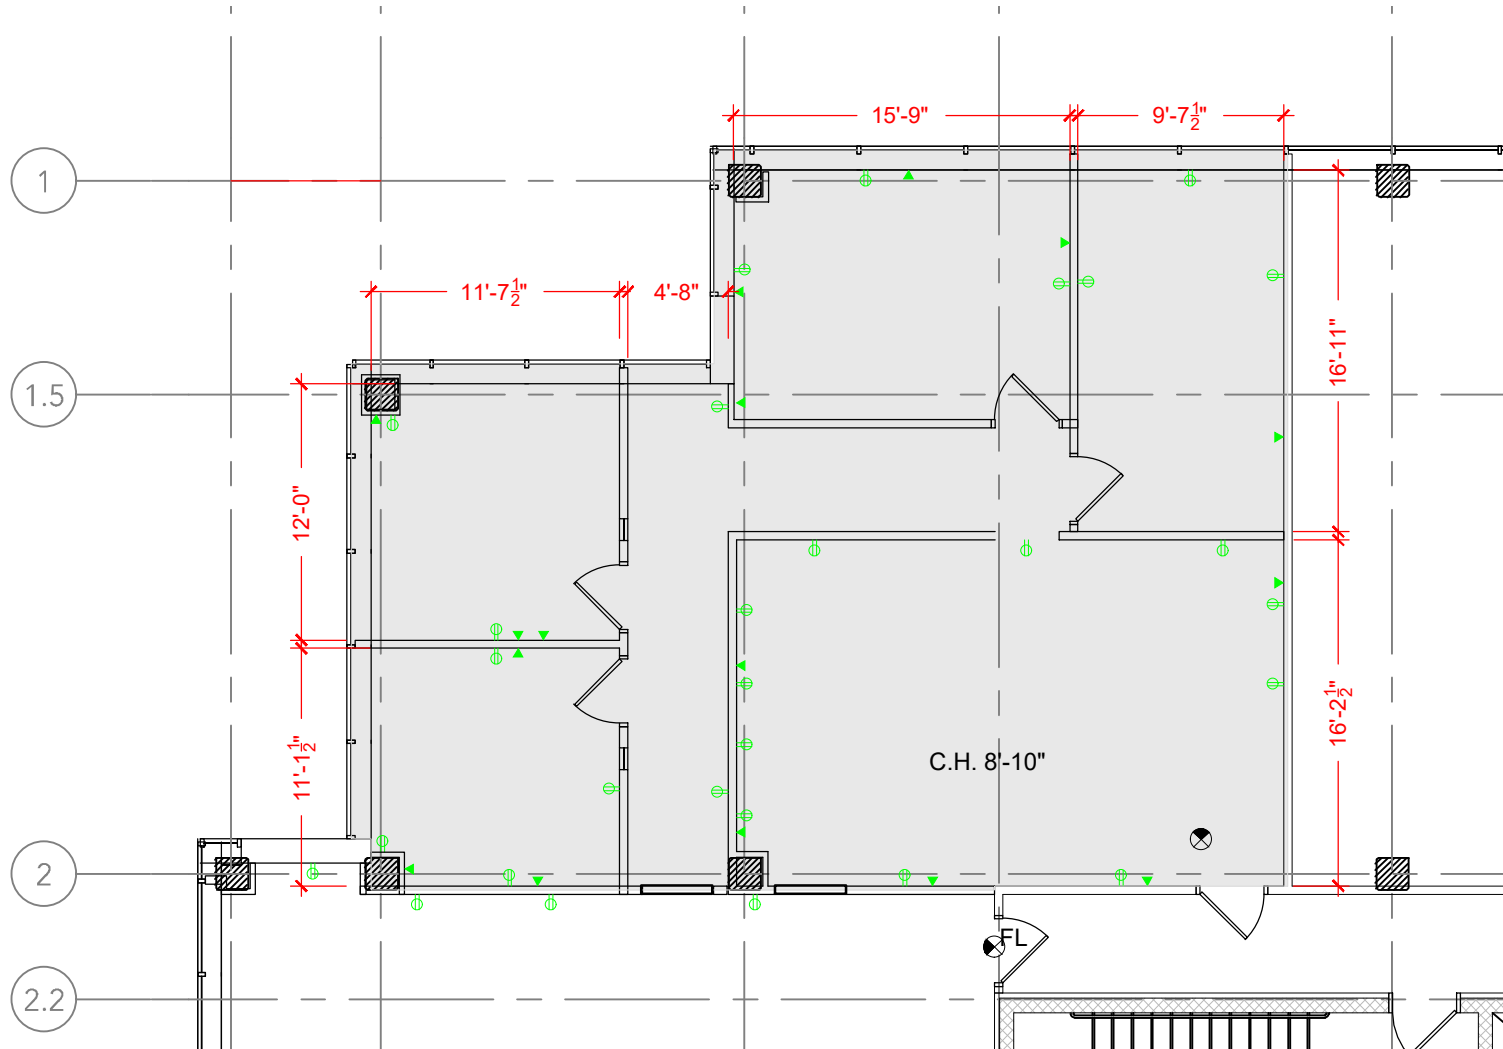

Floor Plan