


TOTAL SF AVAILABLE -7,100 RSF (12%)



[Click to access 3D model](#)

## Key Plan

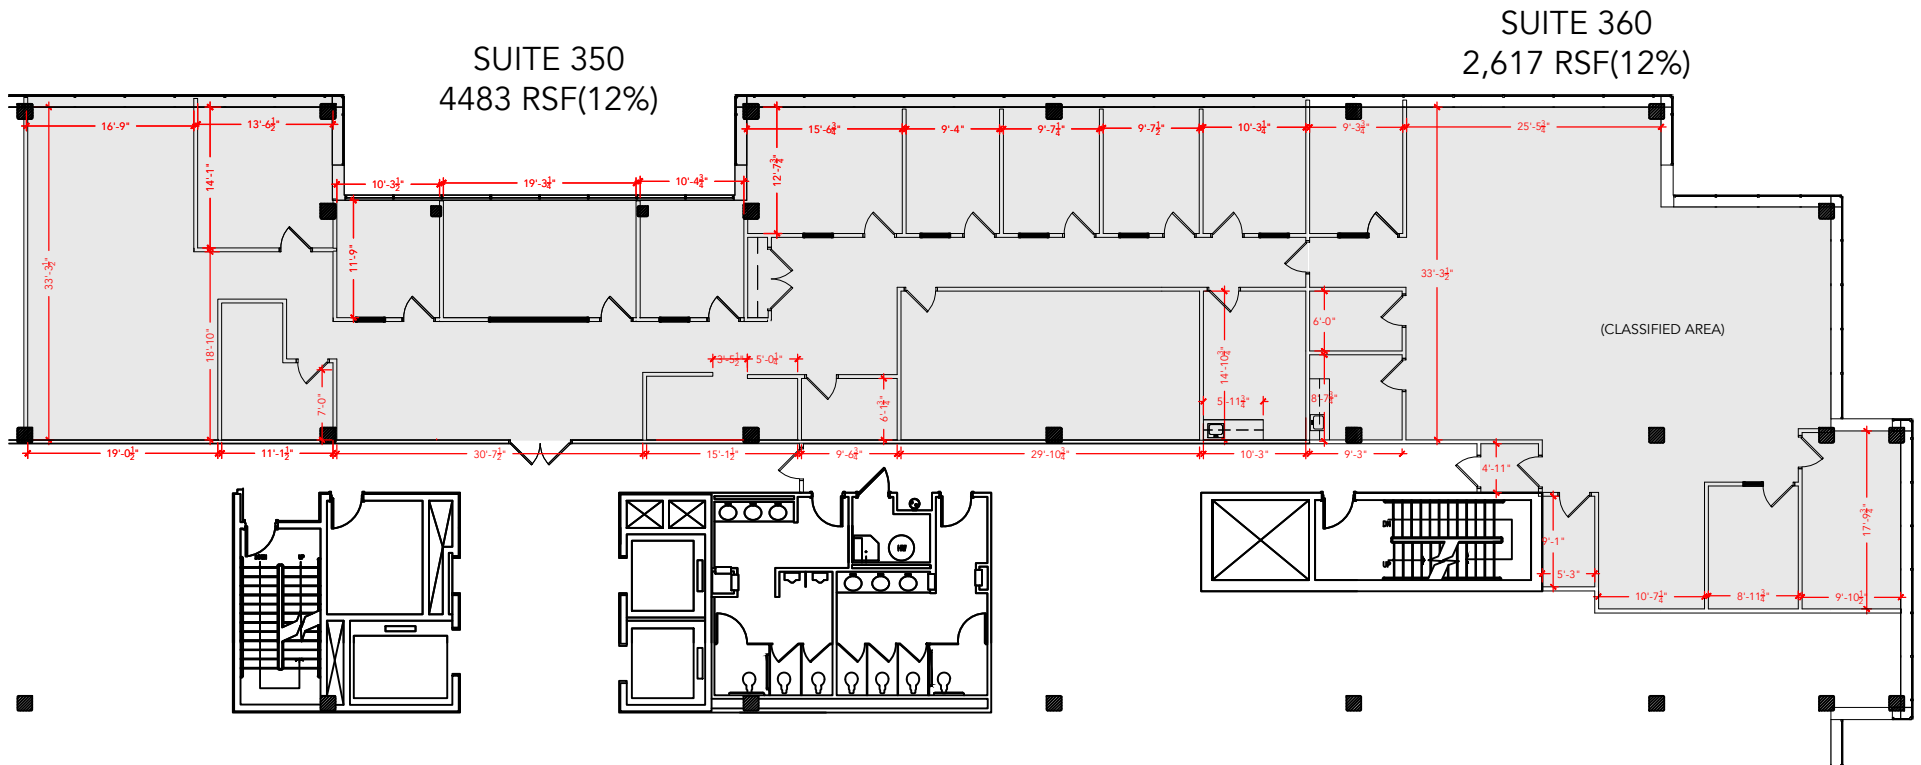

## Floor Plan