

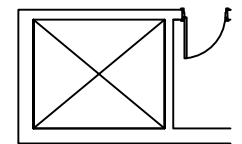
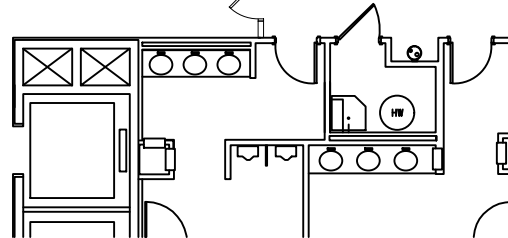


TOTAL SF AVAILABLE -4,483 RSF (12%)

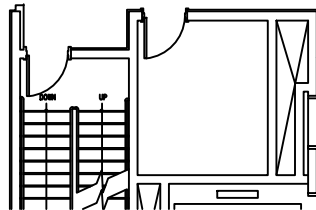

[Click to access 3D model](#)

Key Plan

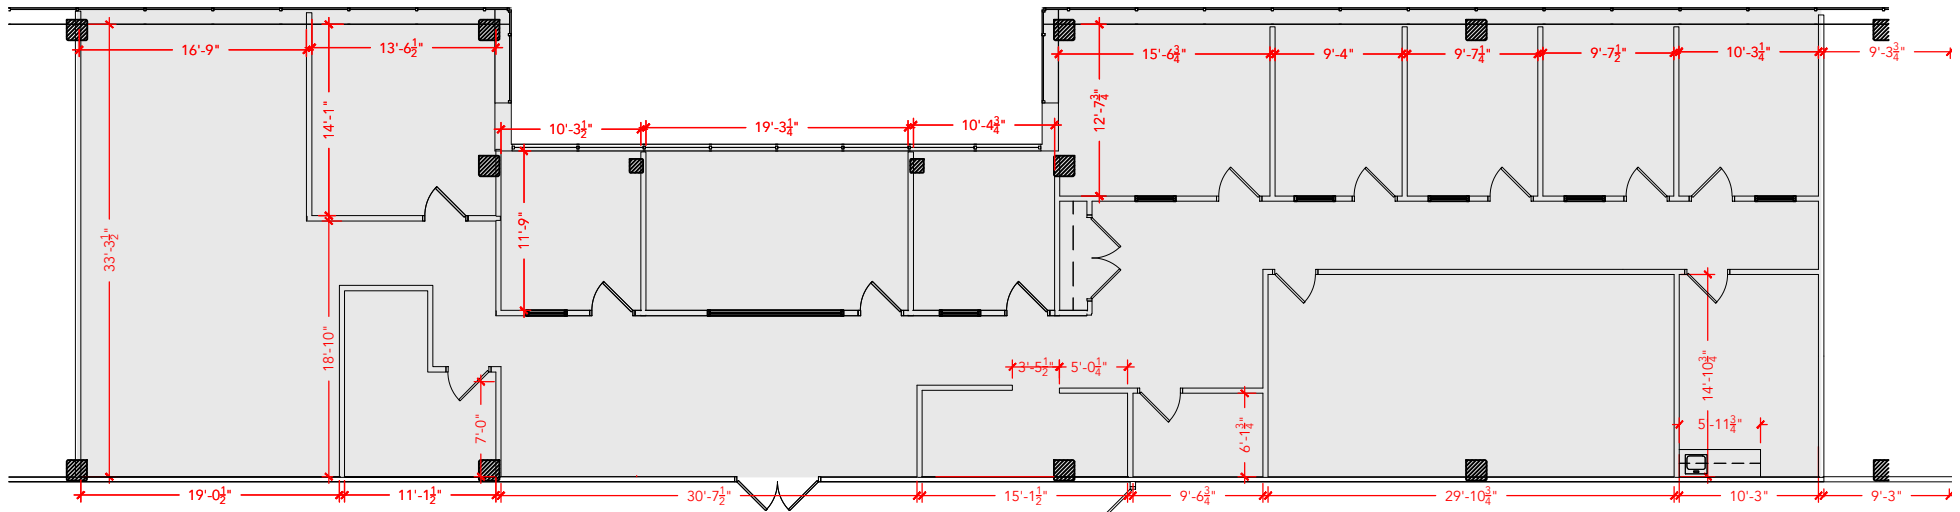

Floor Plan