



TOTAL SF AVAILABLE - 5,476 RSF (16%)

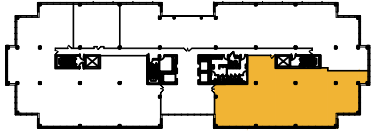

[Click to access 3D model](#)

Key Plan

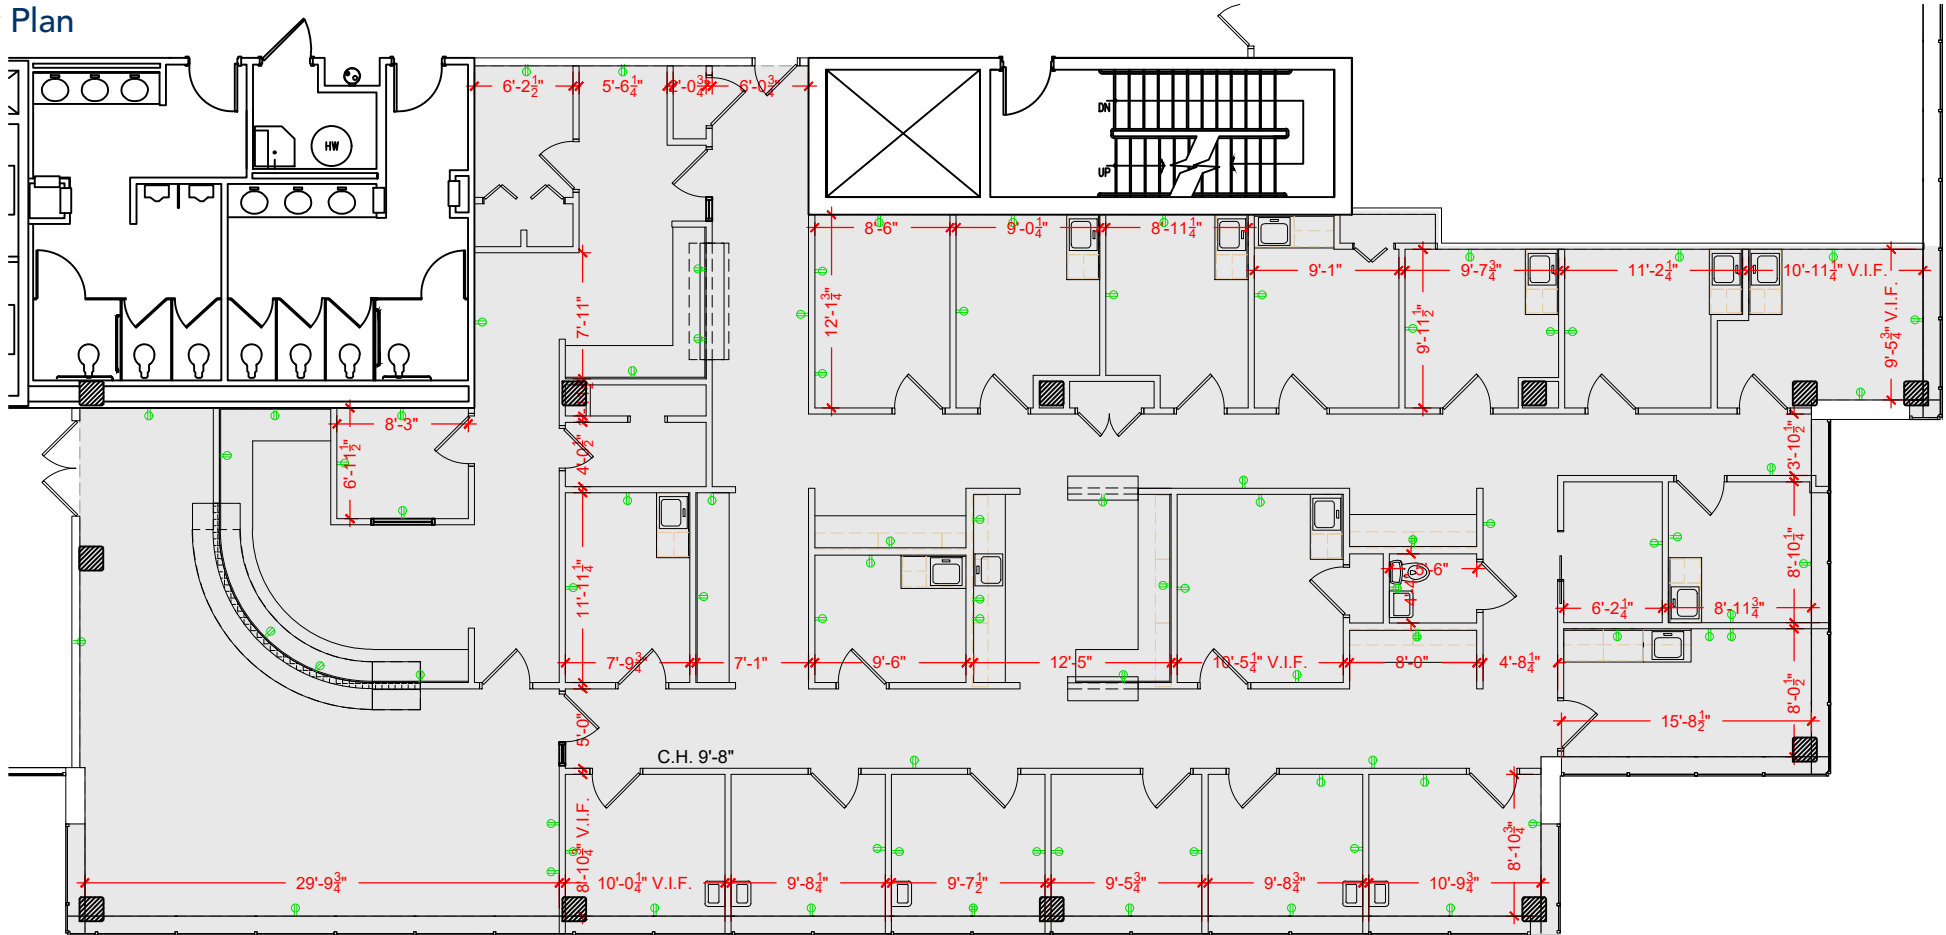

Floor Plan