


TOTAL SF AVAILABLE - 7,549 RSF (12%)



[Click to access 3D model](#)

Key Plan

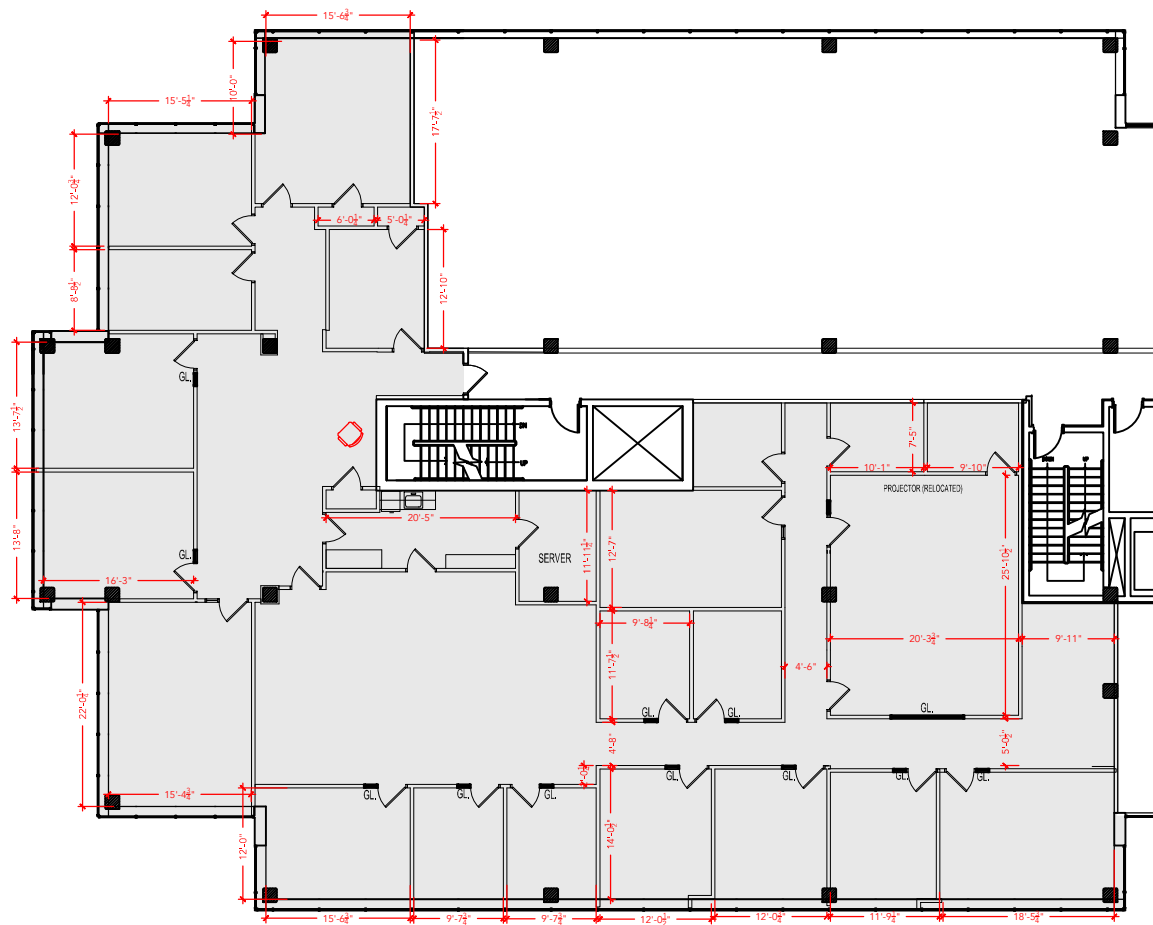

Floor Plan