

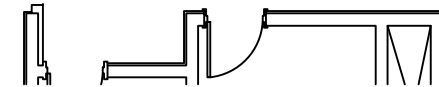


TOTAL SF AVAILABLE - 3,445 RSF (12%)

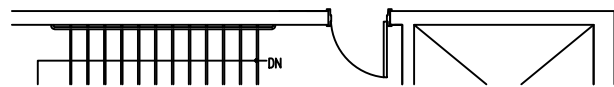

Key Plan

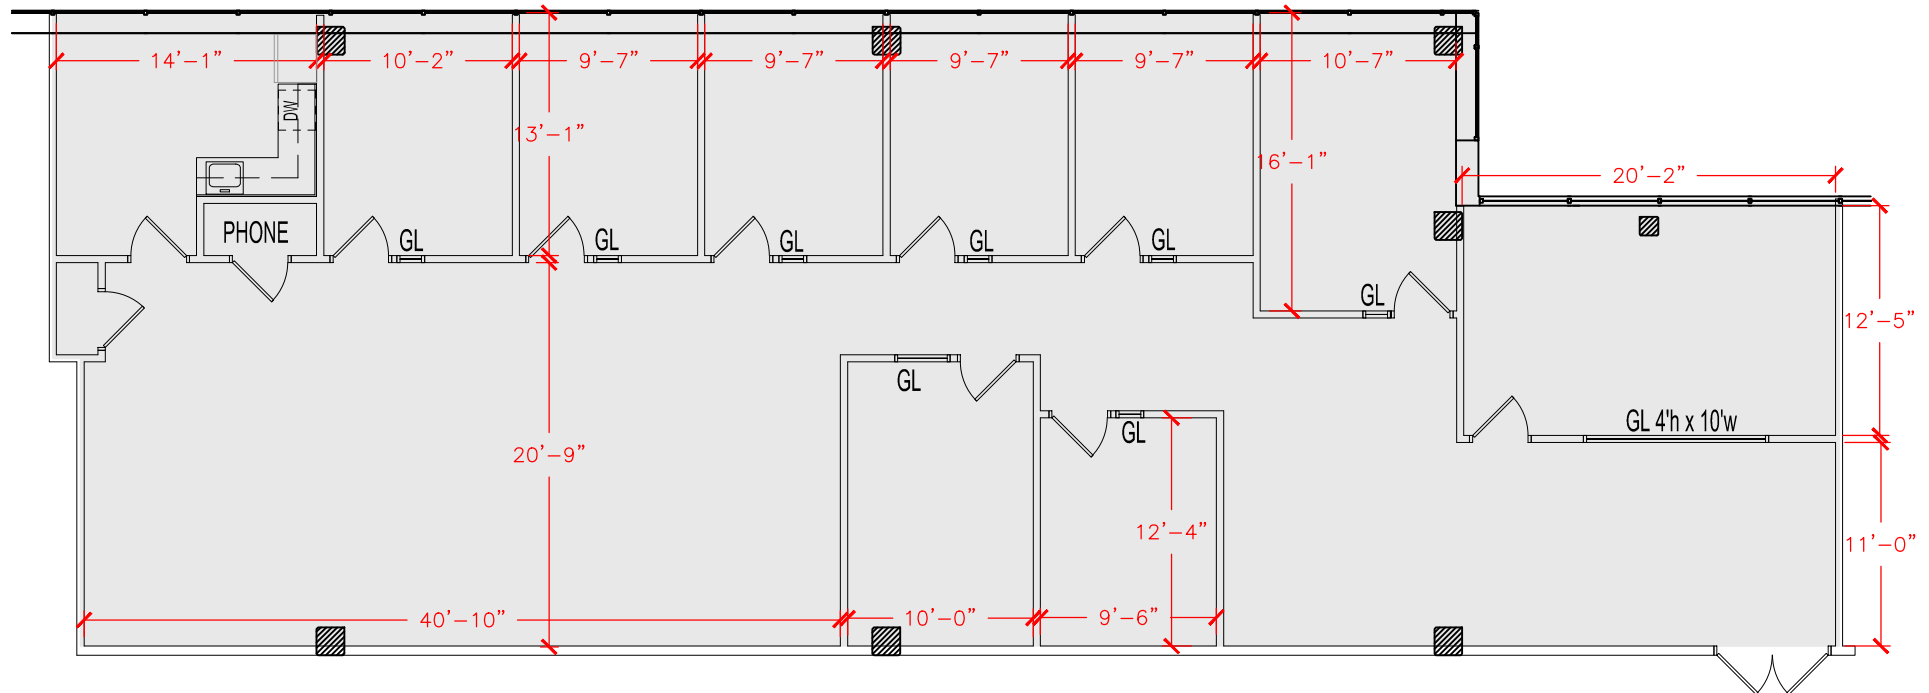

Floor Plan