


TOTAL SF AVAILABLE -1,173 RSF(16%)



[Click to access CADD file](#)

Key Plan

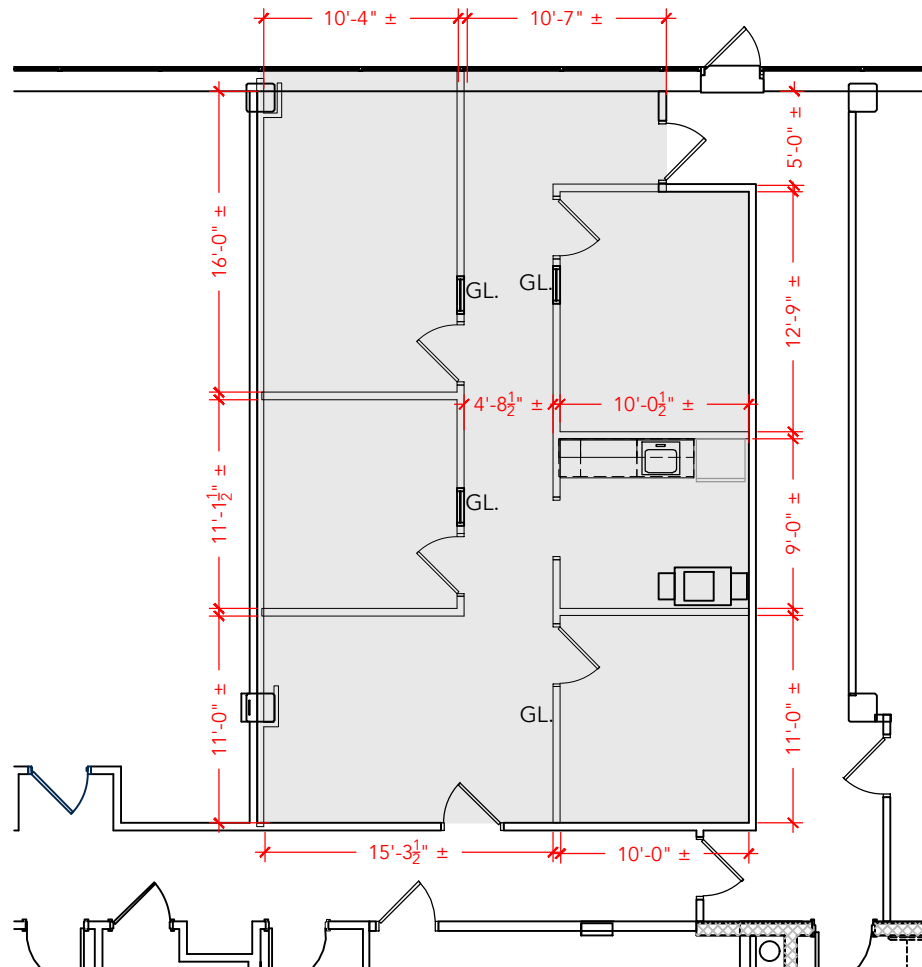

Floor Plan