



TOTAL SF AVAILABLE -1,132 RSF(12%)

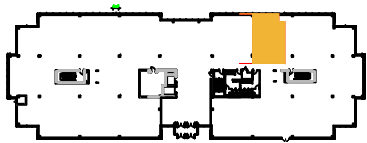

[Click to access 3D model](#)

Key Plan

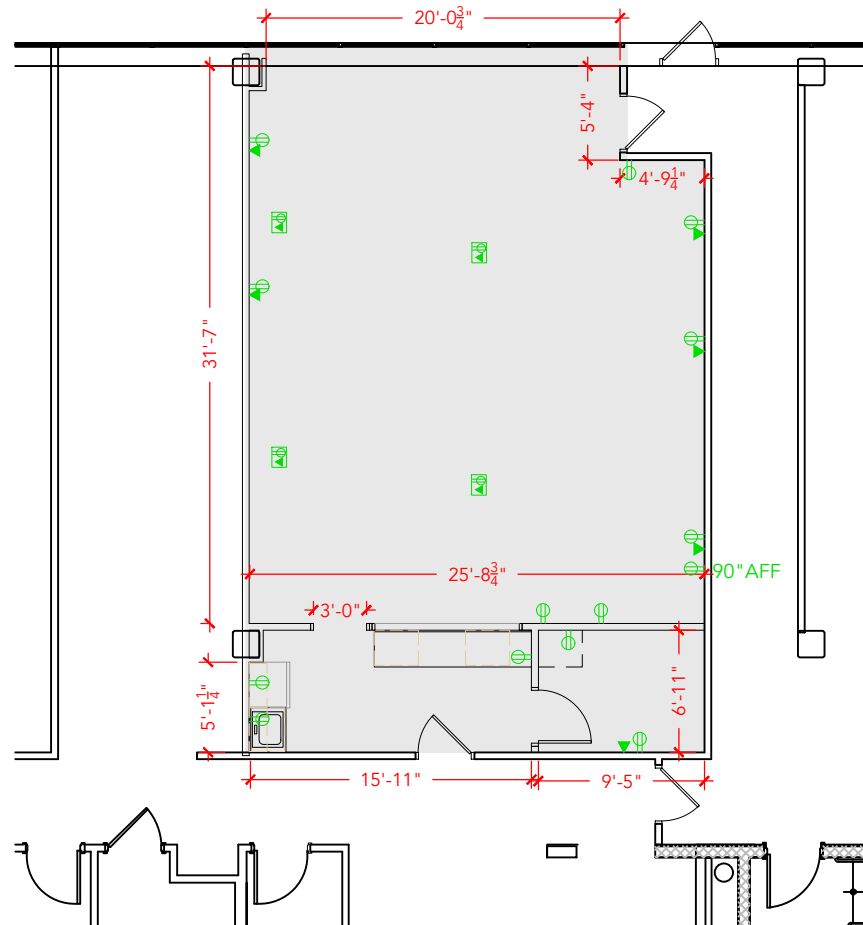

Floor Plan