


TOTAL SF AVAILABLE -8,100 SF


OFFICE - 4,475 SF

WAREHOUSE SF - 3,625 SF

[Click to access CADD file](#)

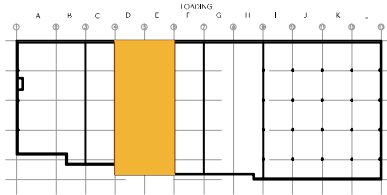

Key Plan

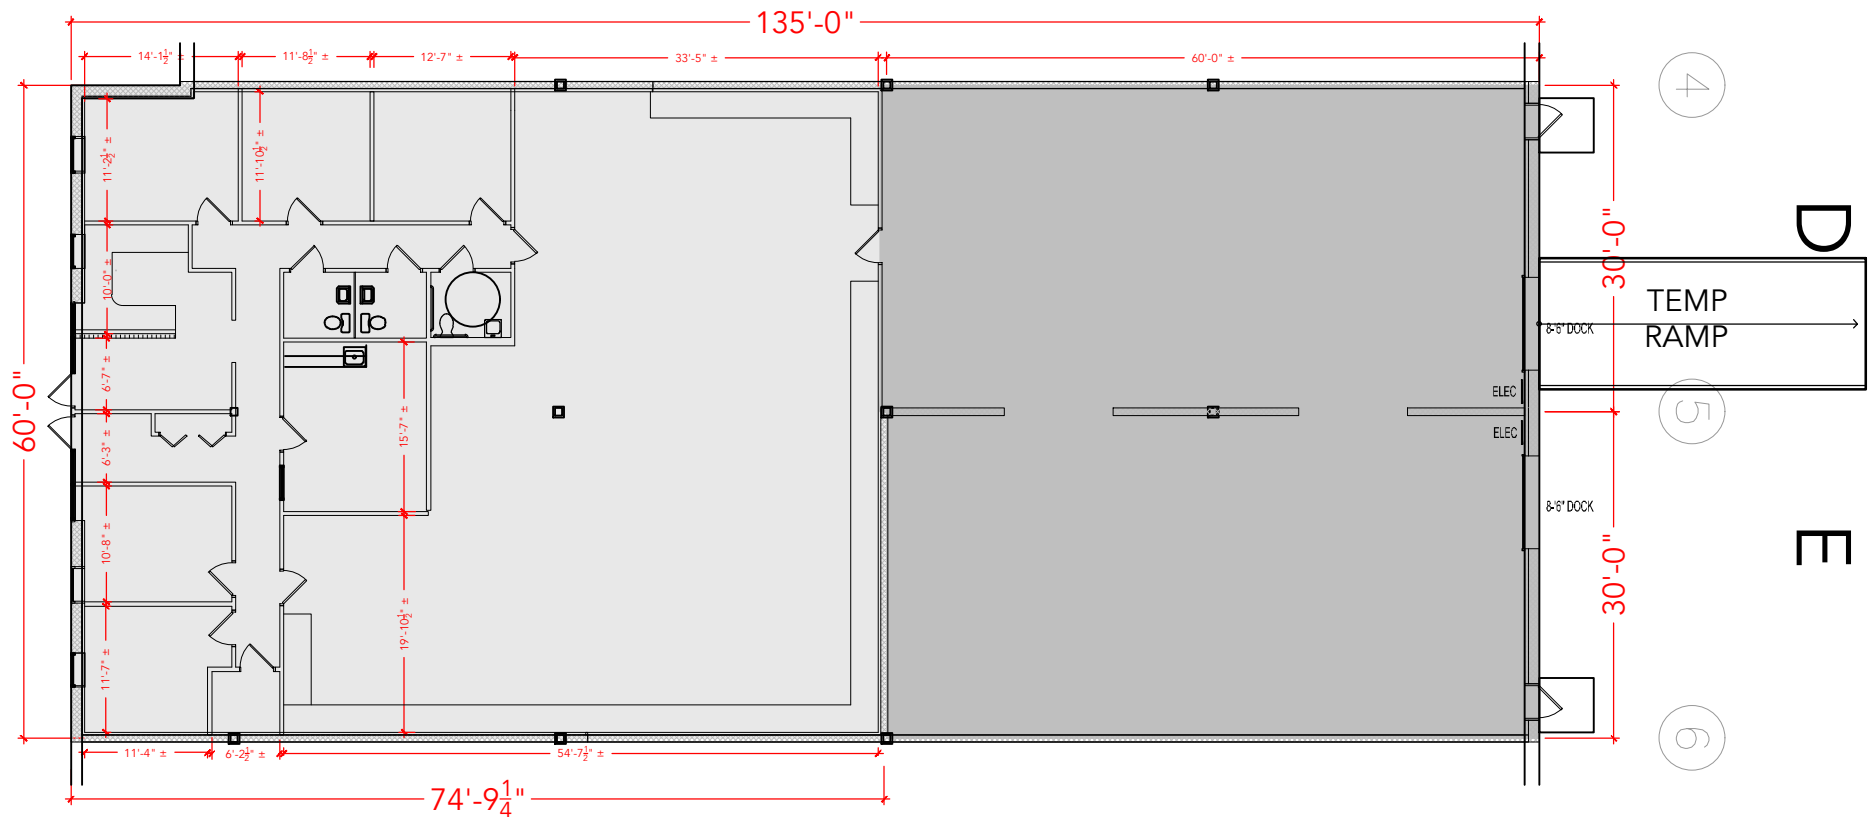

Floor Plan