


**TOTAL SF AVAILABLE -8,110 RSF**

**OFFICE - 4,487 RSF**


**WAREHOUSE - 3,623 RSF**

\* INCLUDES % OF METER ROOM

[Click to access CADD file](#)

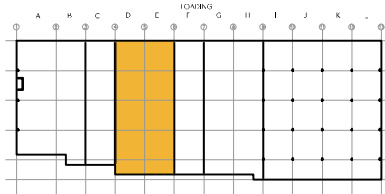

Key Plan

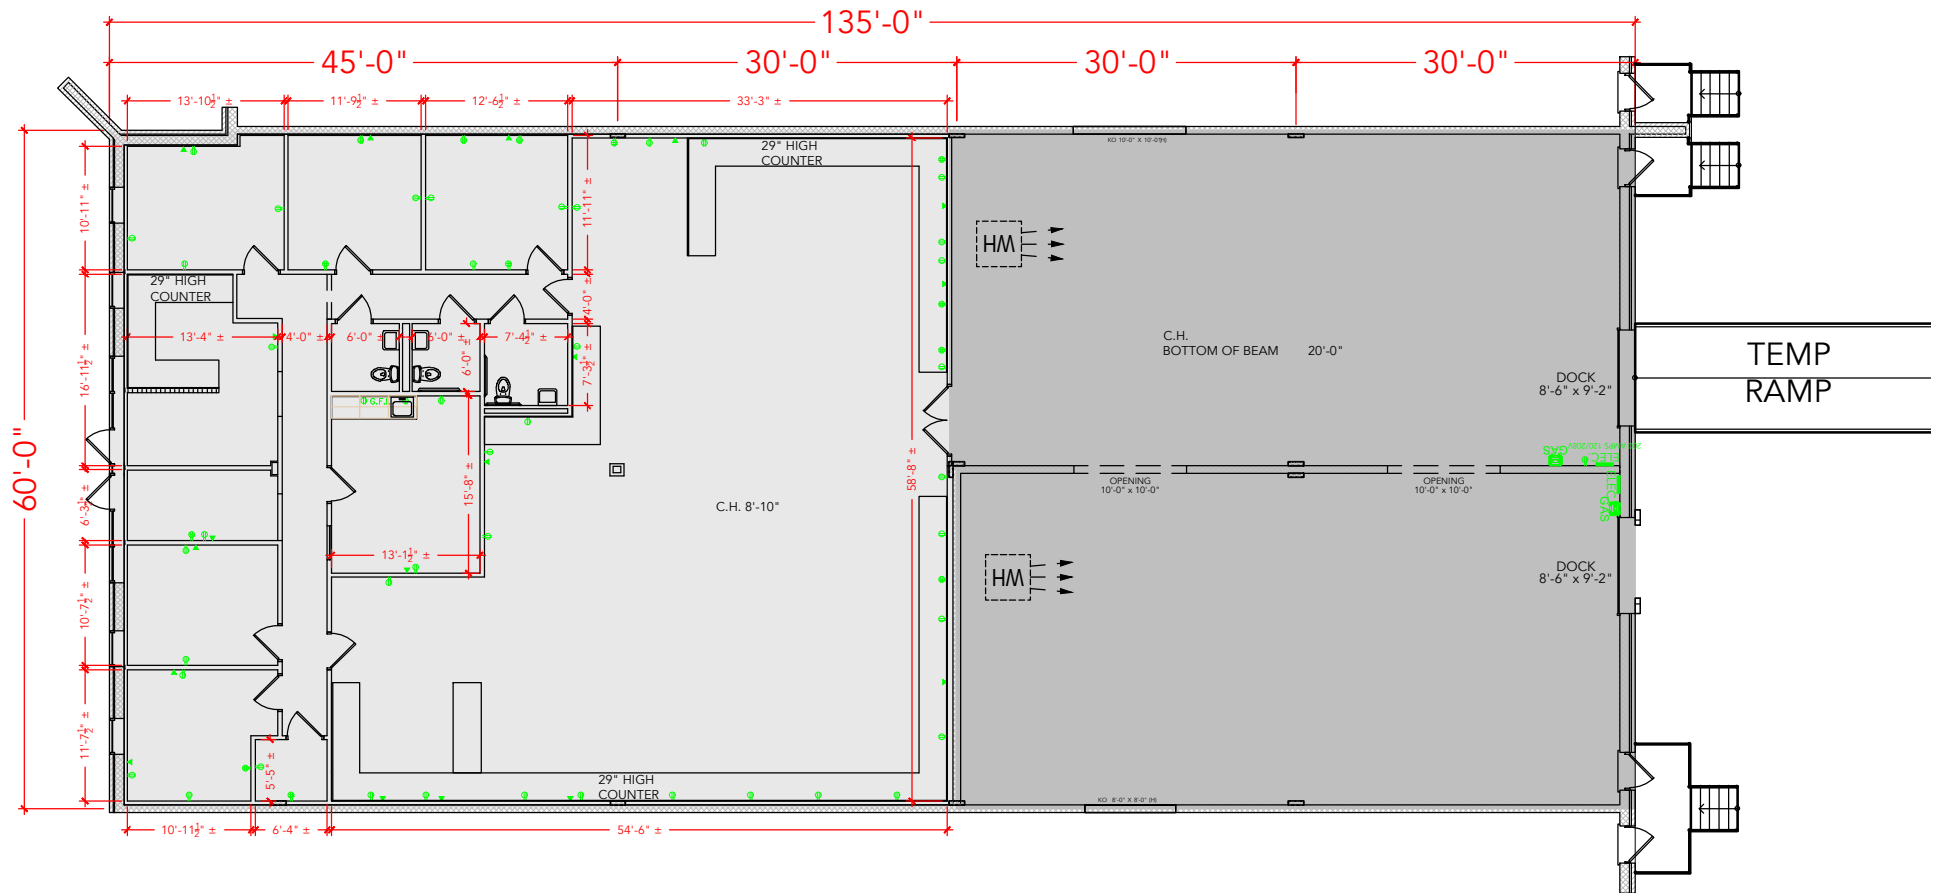

Floor Plan