


**TOTAL SF AVAILABLE - 8,400 SF**


**OFFICE - 2,406 SF**

**WAREHOUSE SF - 5,994 SF**

[Click to access 3D model](#)

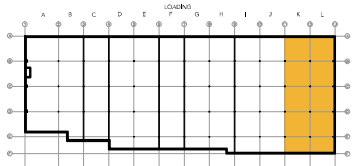

Key Plan

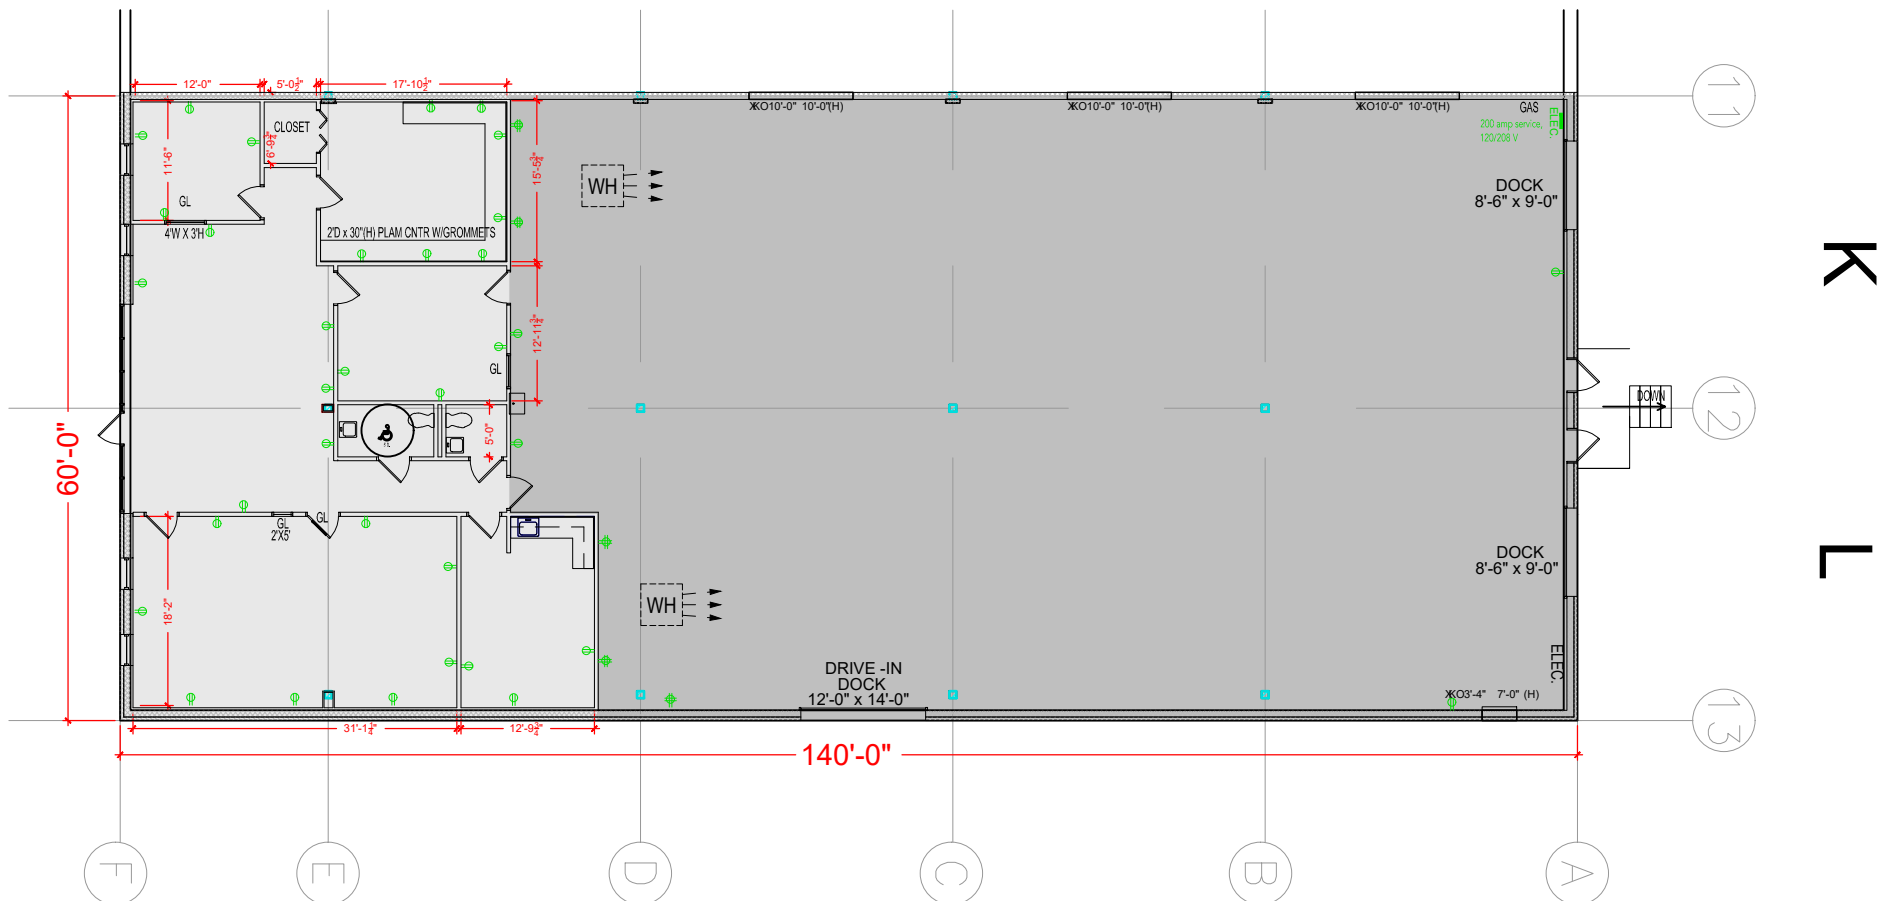

Floor Plan