


TOTAL SF AVAILABLE - 25,350 SF


OFFICE - 3,535 SF

WAREHOUSE - 21,825

[Click to access 3D model](#)

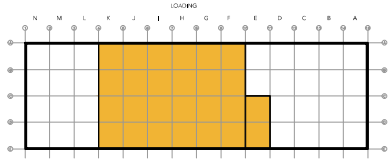

Key Plan

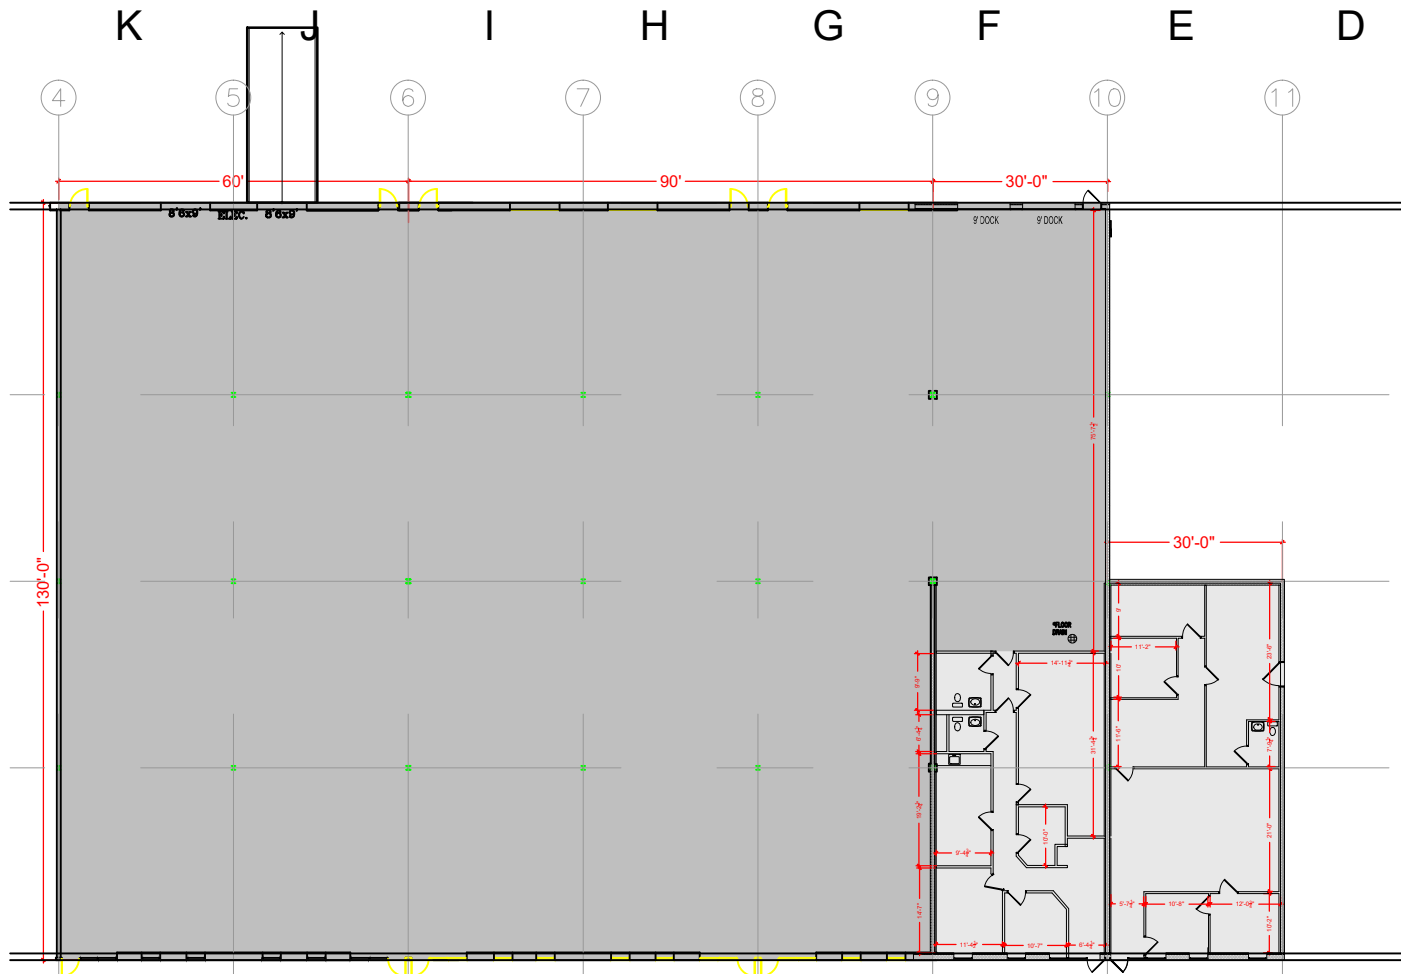

Floor Plan