



TOTAL SF AVAILABLE - 25,350 SF

OFFICE - 3,126 SF
WAREHOUSE - 22,224 SF

[Click to access CADD file](#)

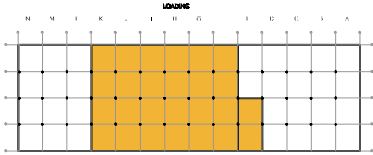

Key Plan

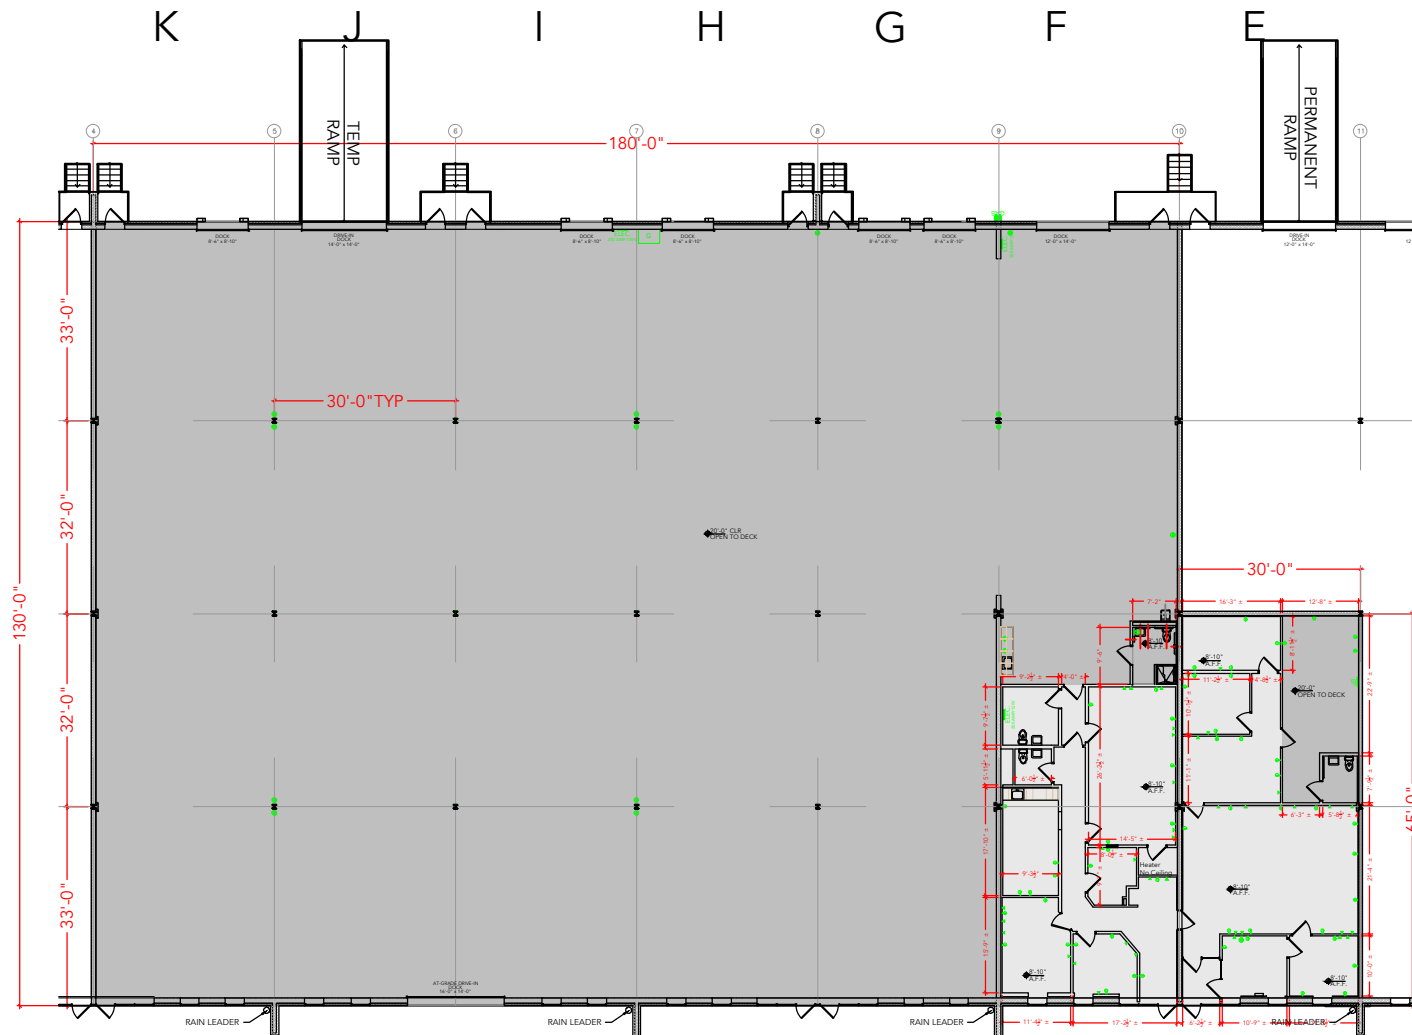

Floor Plan