


TOTAL SF AVAILABLE -11,700 SF


OFFICE - 2,950 SF

WAREHOUSE - 8,750 SF

[Click to access CADD file](#)

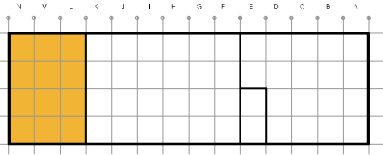

Key Plan

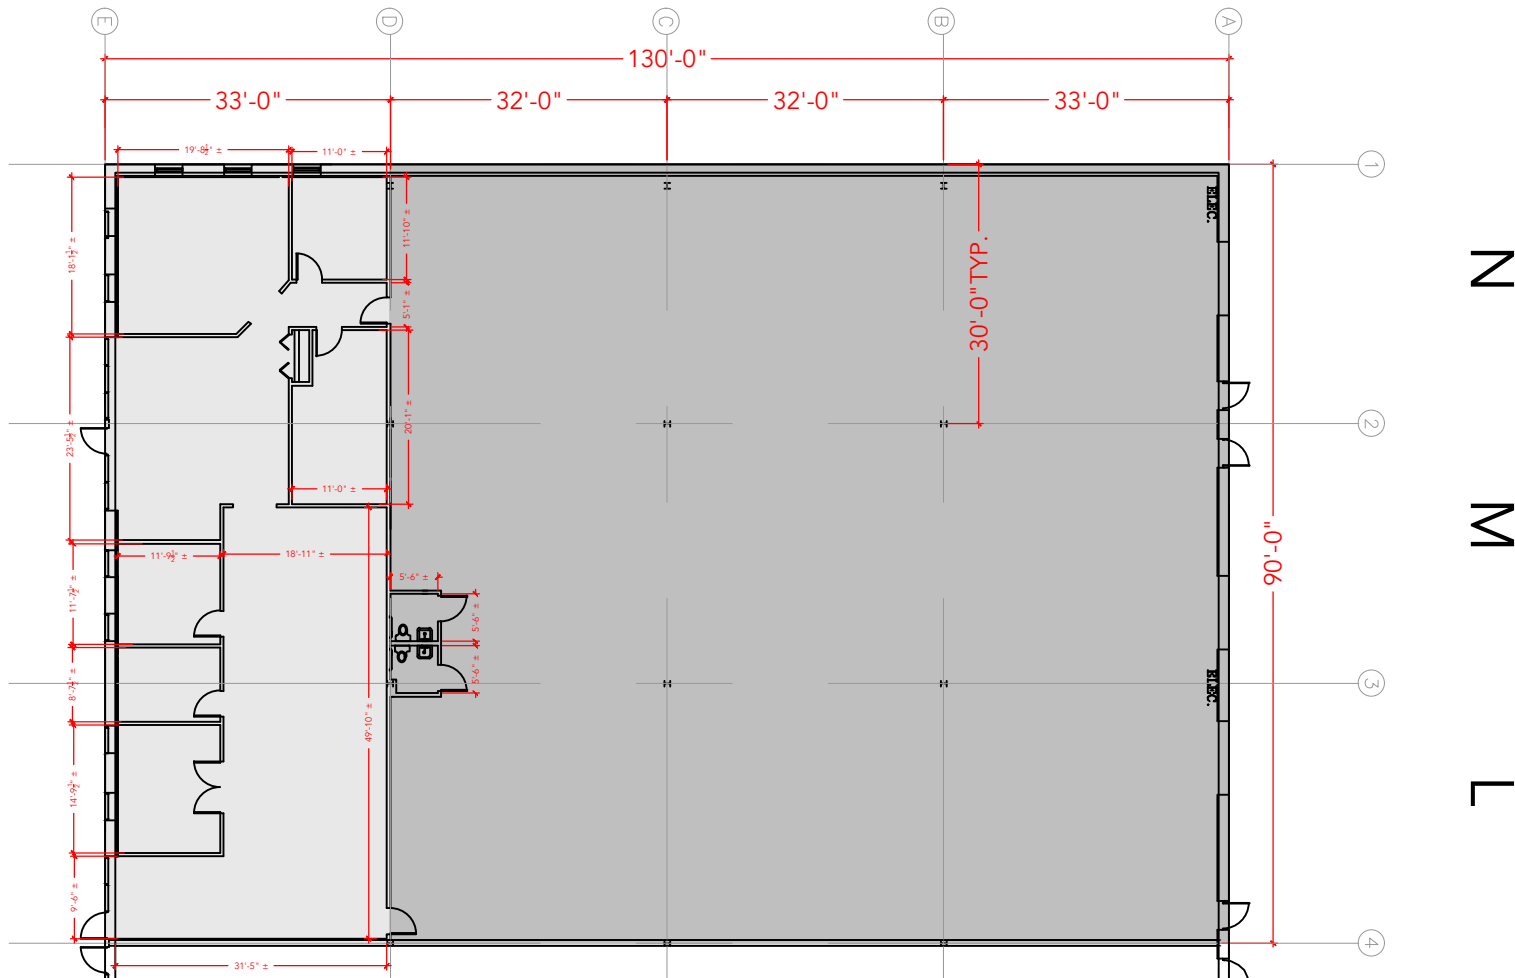

Floor Plan