


TOTAL SF AVAILABLE -12,295 RSF

OFFICE - 1,246 RSF


WAREHOUSE - 11,049 RSF

* INCLUDES % OF METER ROOM

[Click to access CADD file](#)

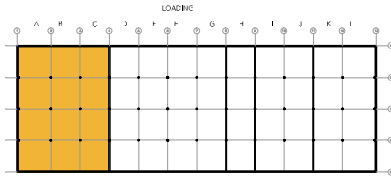

Key Plan

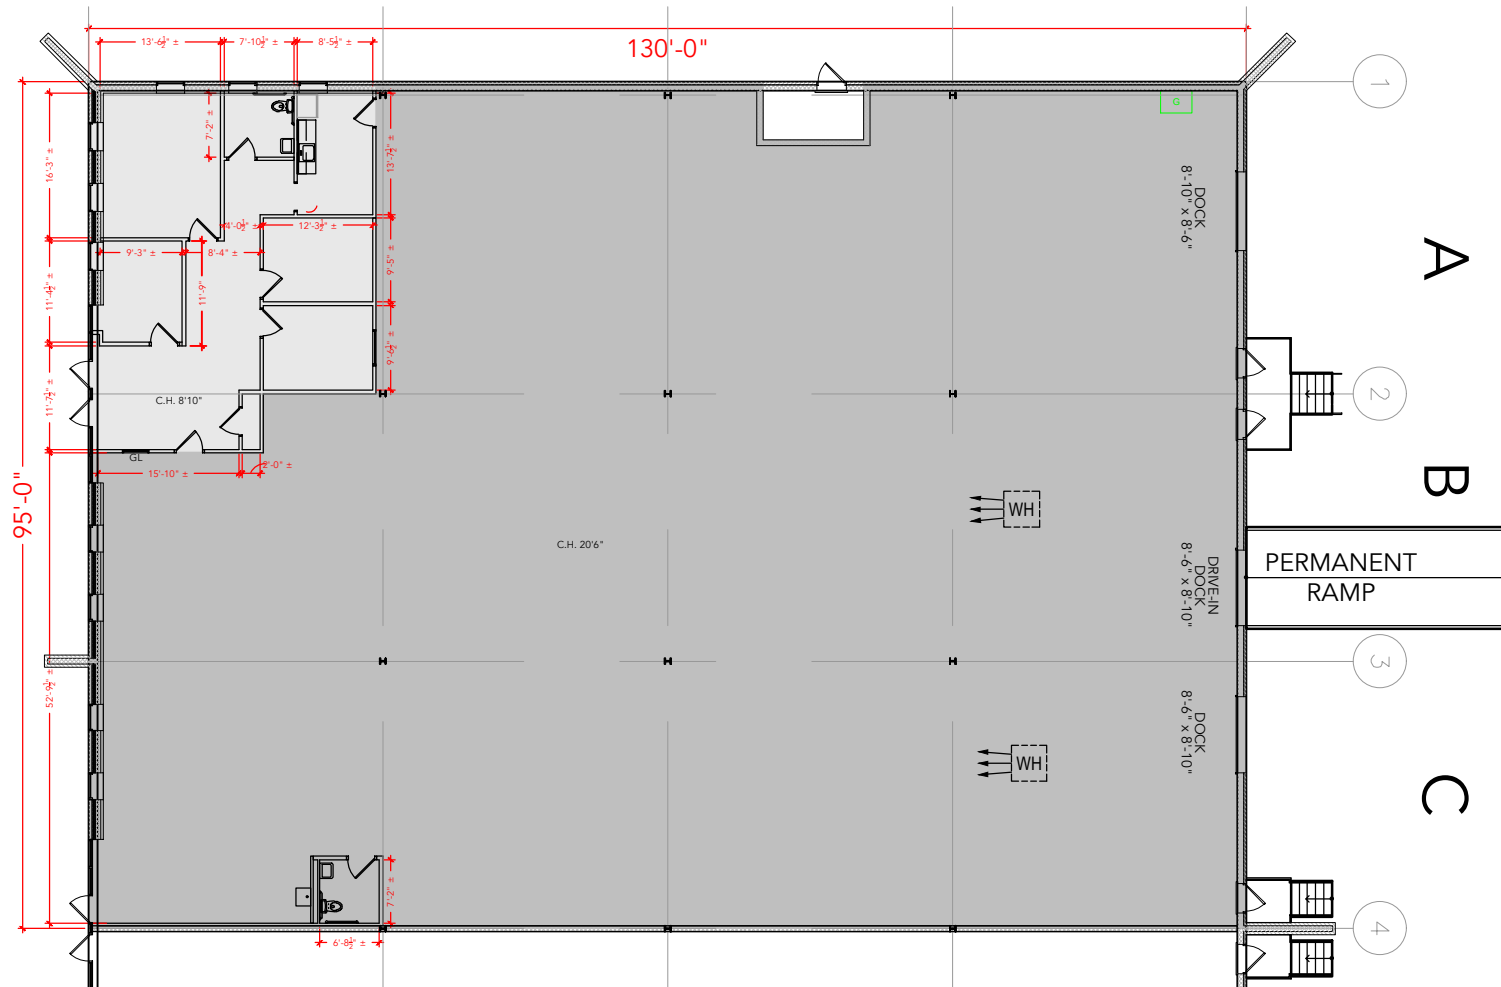

Floor Plan