


**TOTAL SF AVAILABLE -11,584 RSF**

OFFICE - 6,023 RSF


WAREHOUSE - 5,561 RSF

\* INCLUDES % OF METER ROOM

[Click to access CADD file](#)

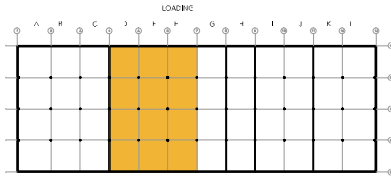

Key Plan

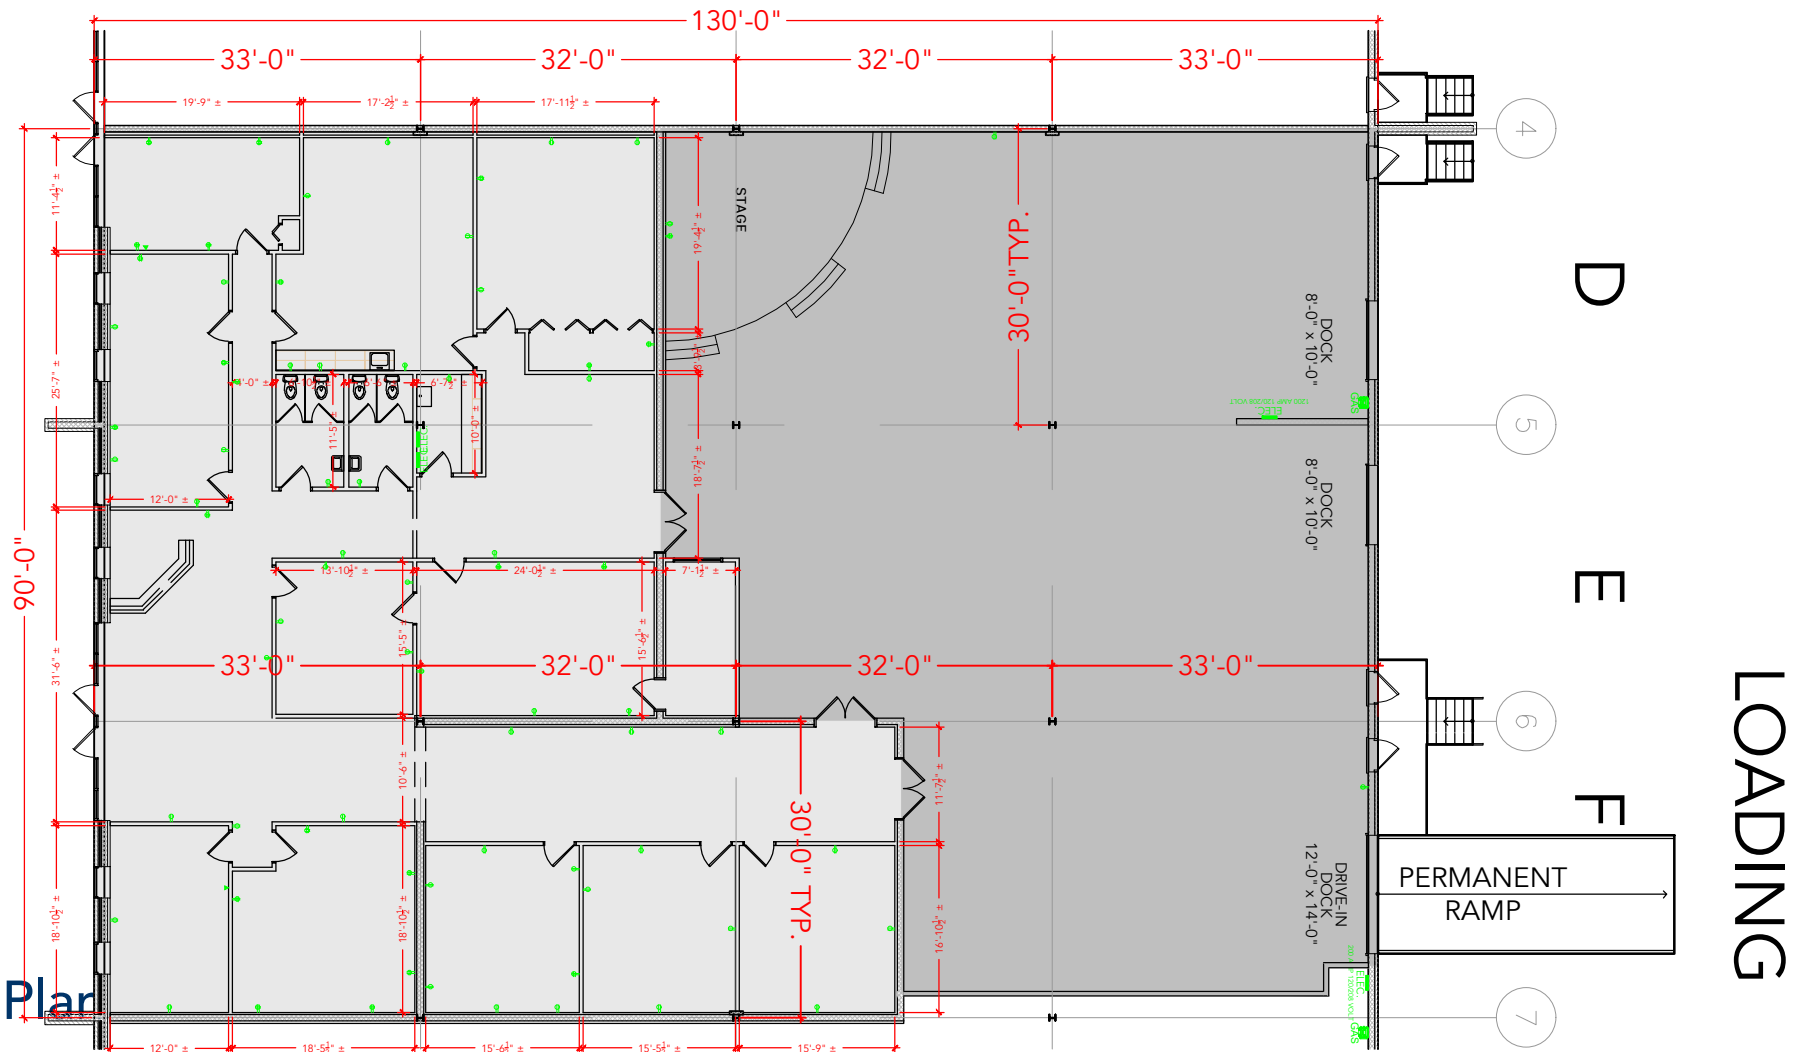

**LOADING**

Floor Plan