


TOTAL SF AVAILABLE - 15,600 SF


OFFICE - 8,463 SF

WAREHOUSE SF - 7,137 SF

[Click to access 3D model](#)

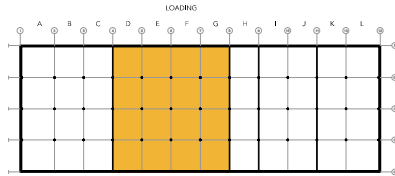

Key Plan

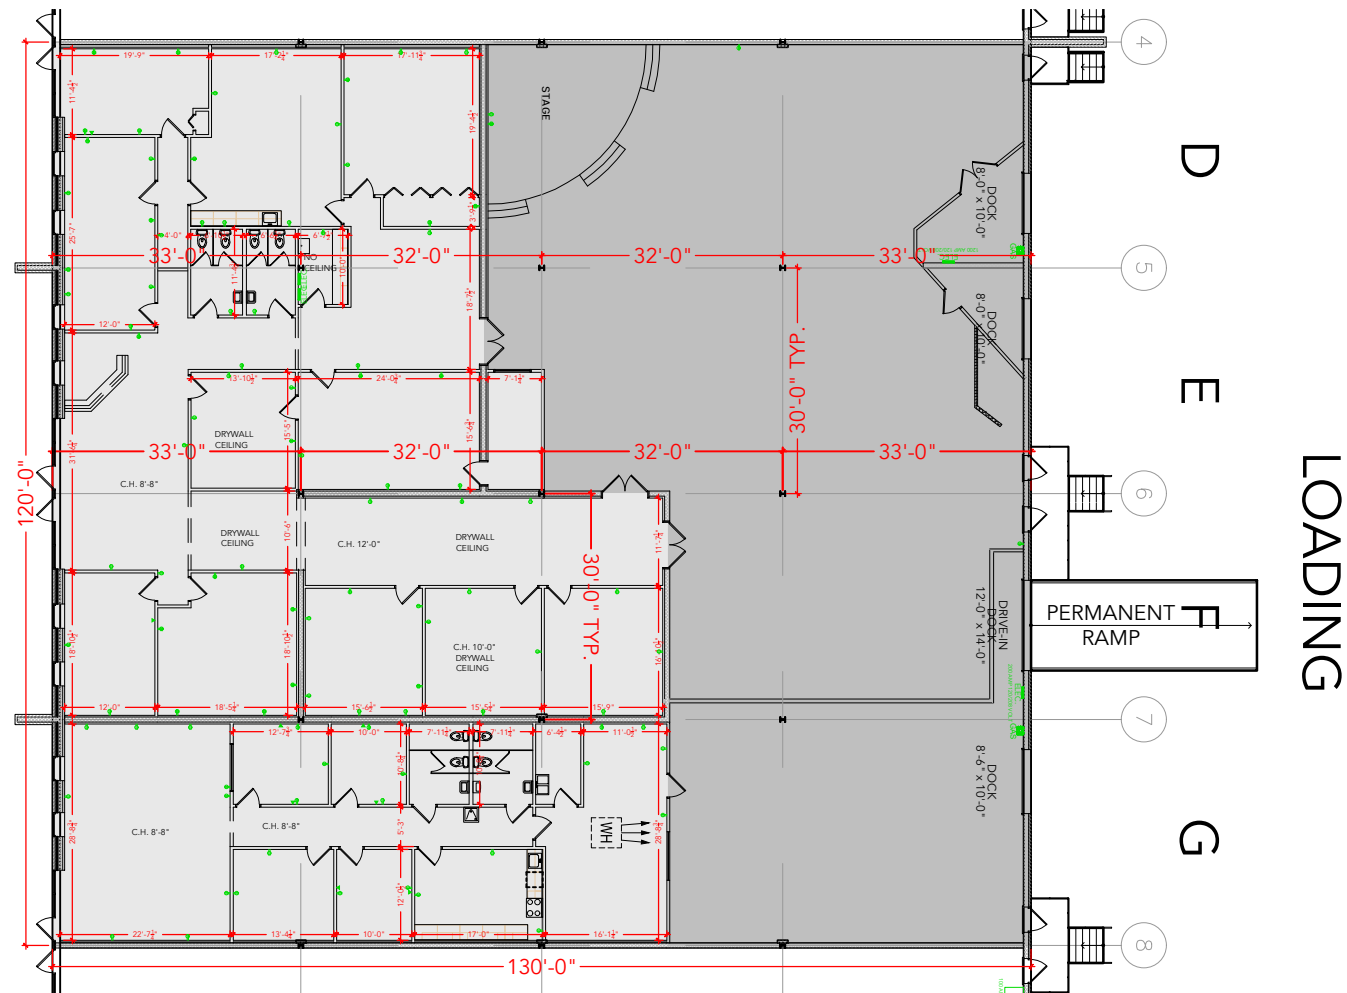

Floor Plan