


**TOTAL SF AVAILABLE - 4,034 SF**


OFFICE - 2,449 SF

WAREHOUSE SF - 1,585 SF

[Click to access 3D model](#)

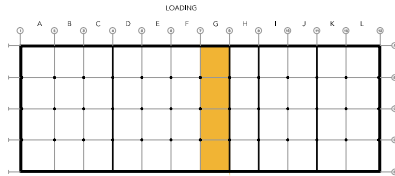

Key Plan

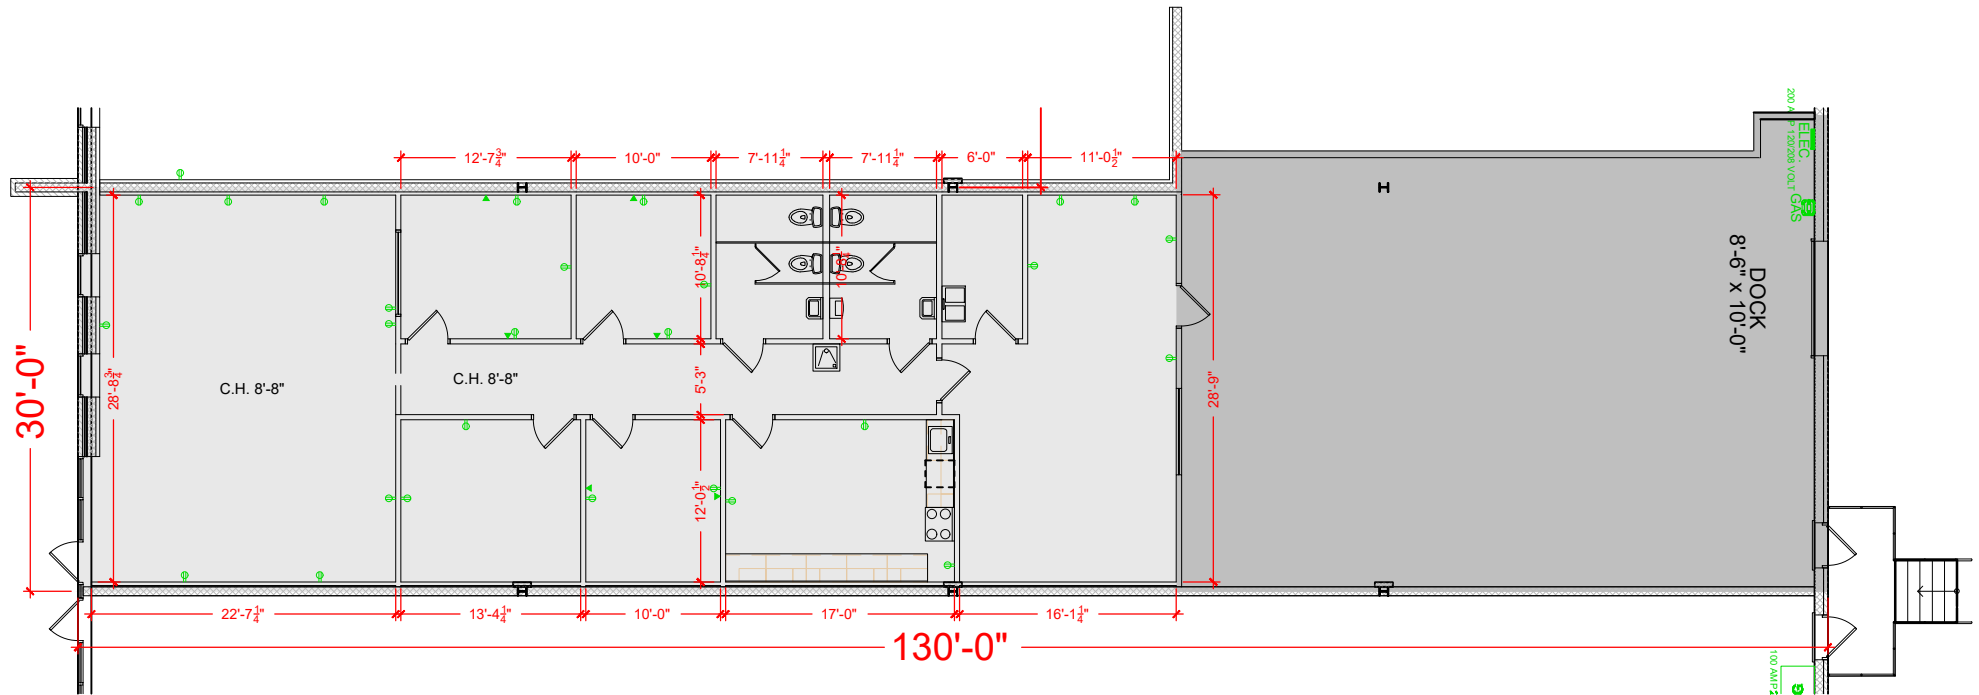

Floor Plan