


**TOTAL SF AVAILABLE - 7,800 SF**


**OFFICE - 2,272 SF**

**WAREHOUSE - 5,528 SF**

[Click to access 3D model](#)

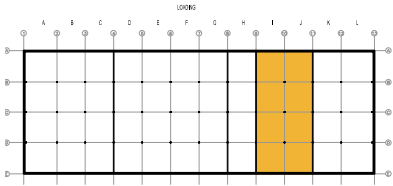

Key Plan

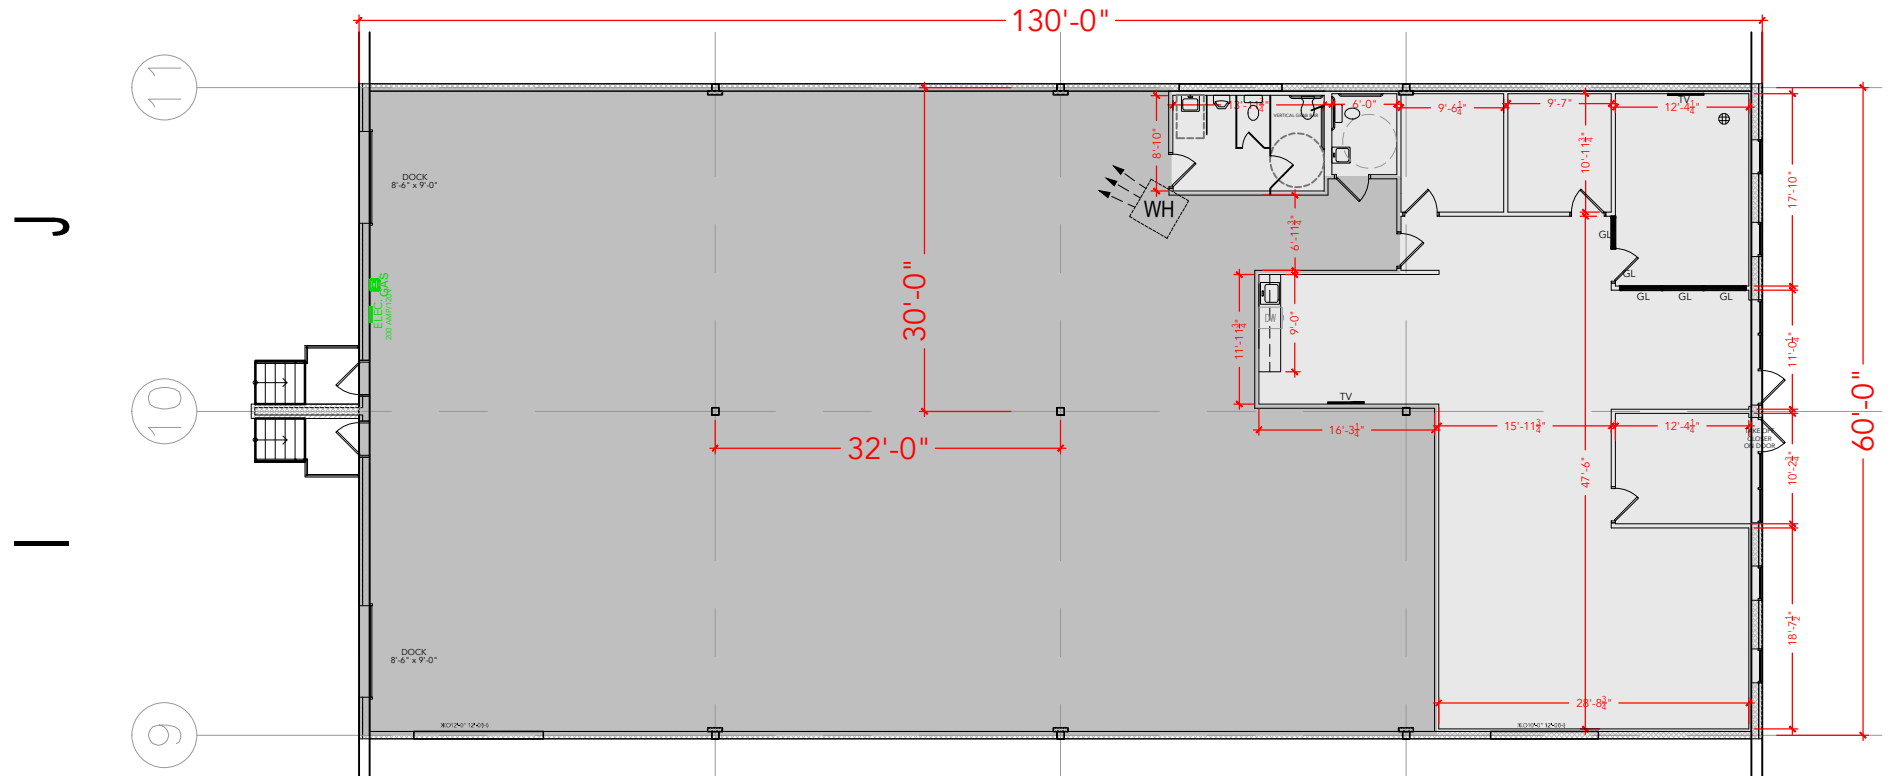

## Floor Plan