


TOTAL SF AVAILABLE -7,200 SF


OFFICE - 2,528 SF

WAREHOUSE SF - 4,672 SF

[Click to access 3D model](#)

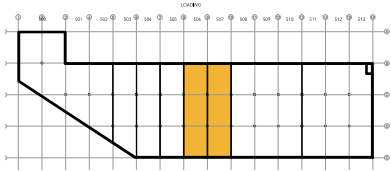

Key Plan

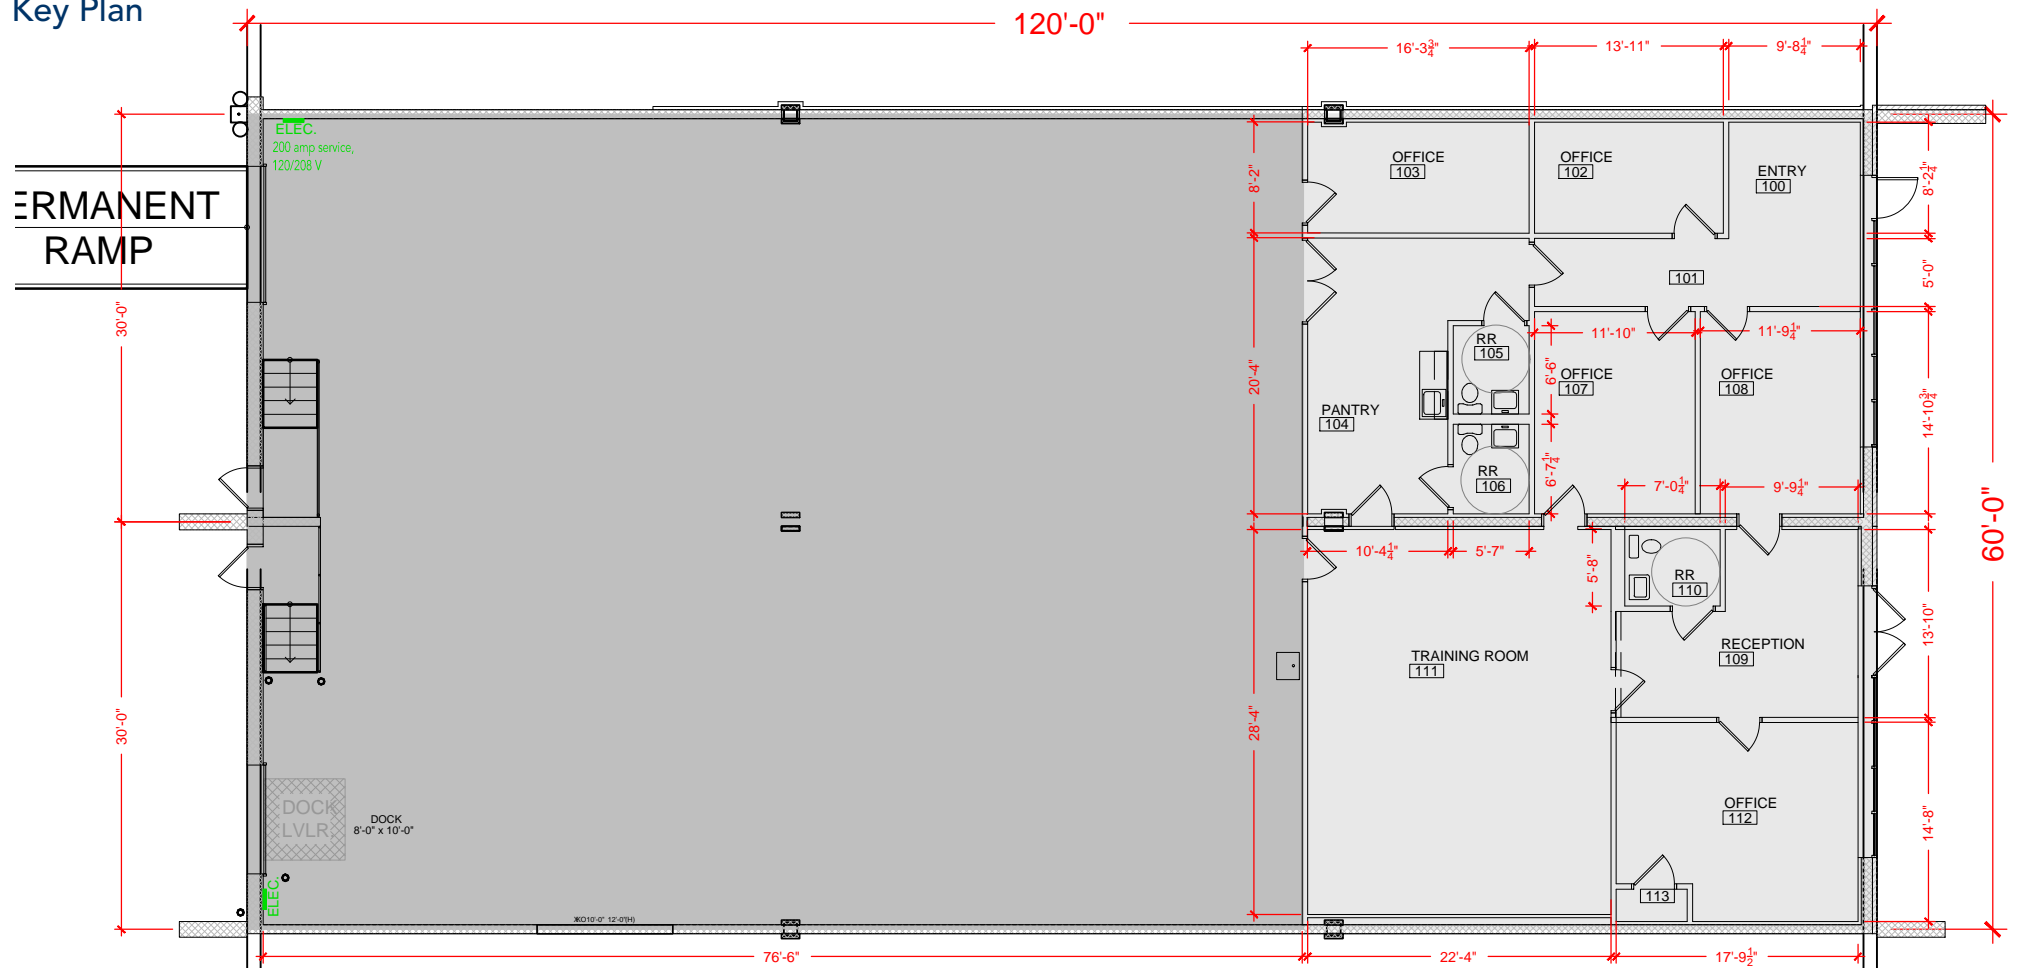

Floor Plan