



**TOTAL SF AVAILABLE - 6,897 SF**

OFFICE - 5,960 SF  
WAREHOUSE - 937 SF

[Click to access 3D model](#)

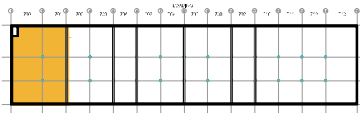

Key Plan

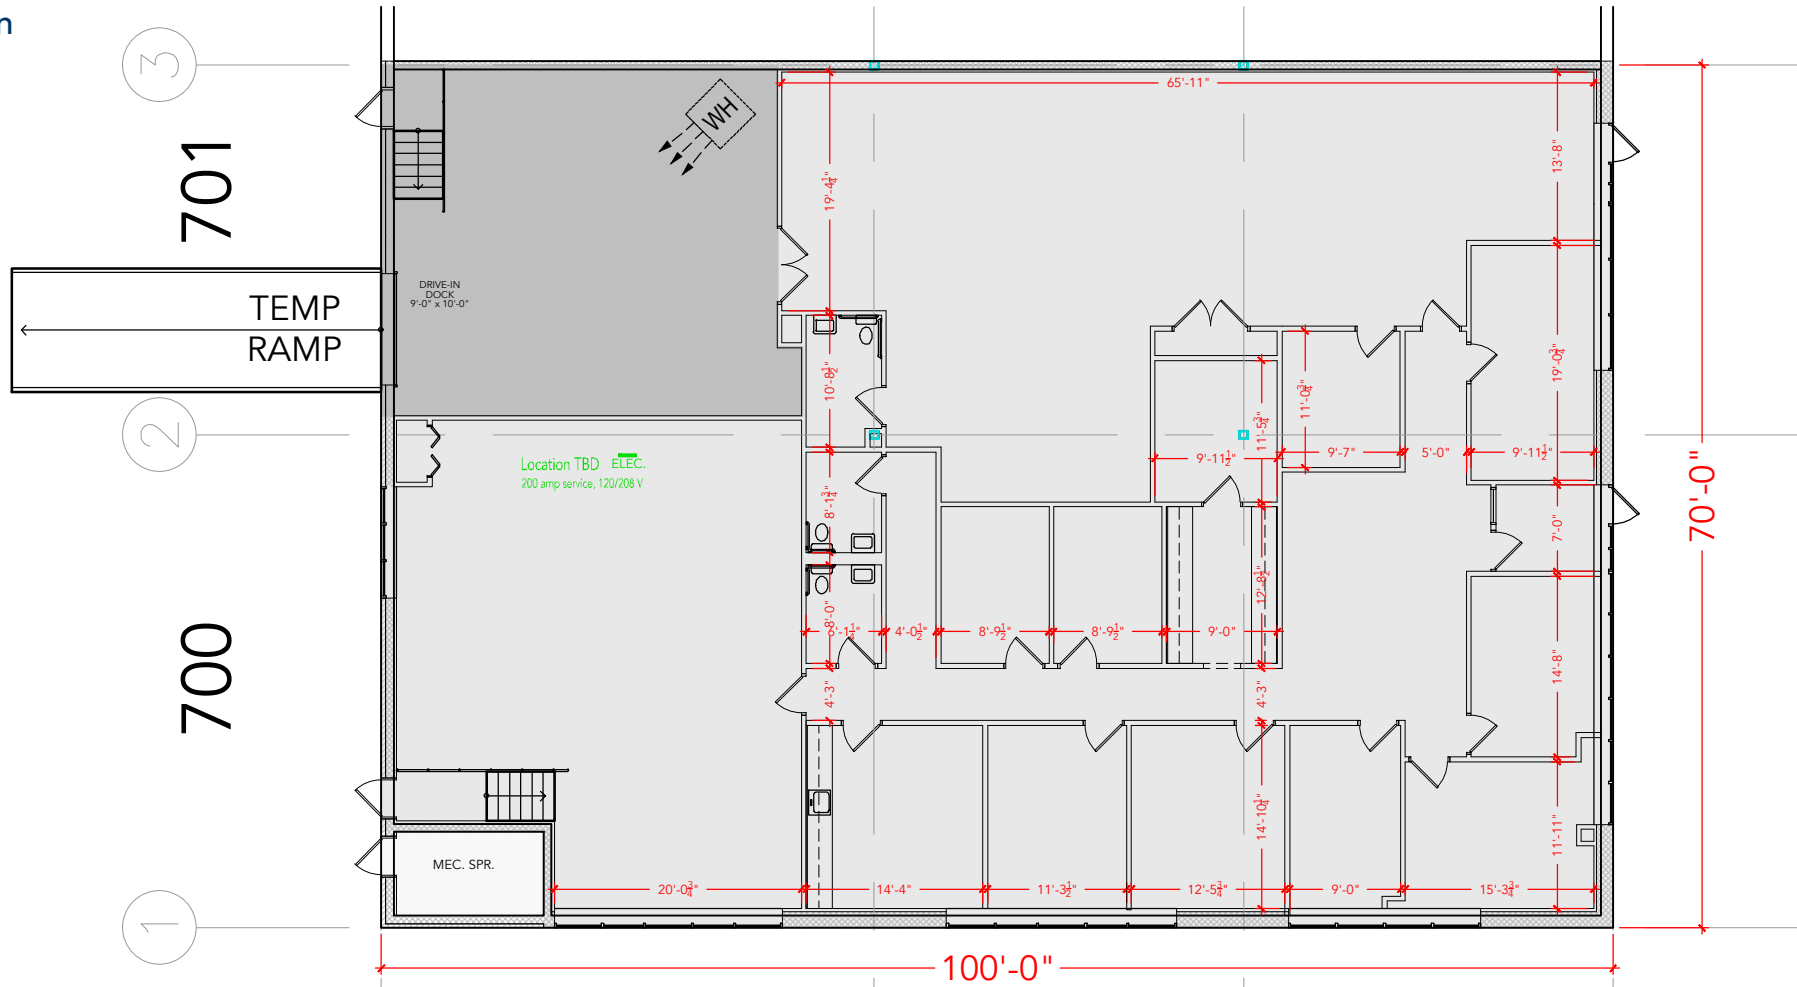

Floor Plan