



**TOTAL SF AVAILABLE - 6,897 SF**

OFFICE - 5,953 SF  
WAREHOUSE - 944 SF

[Click to access 3D model](#)

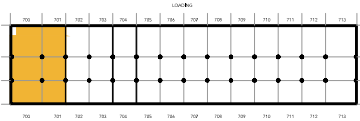

Key Plan

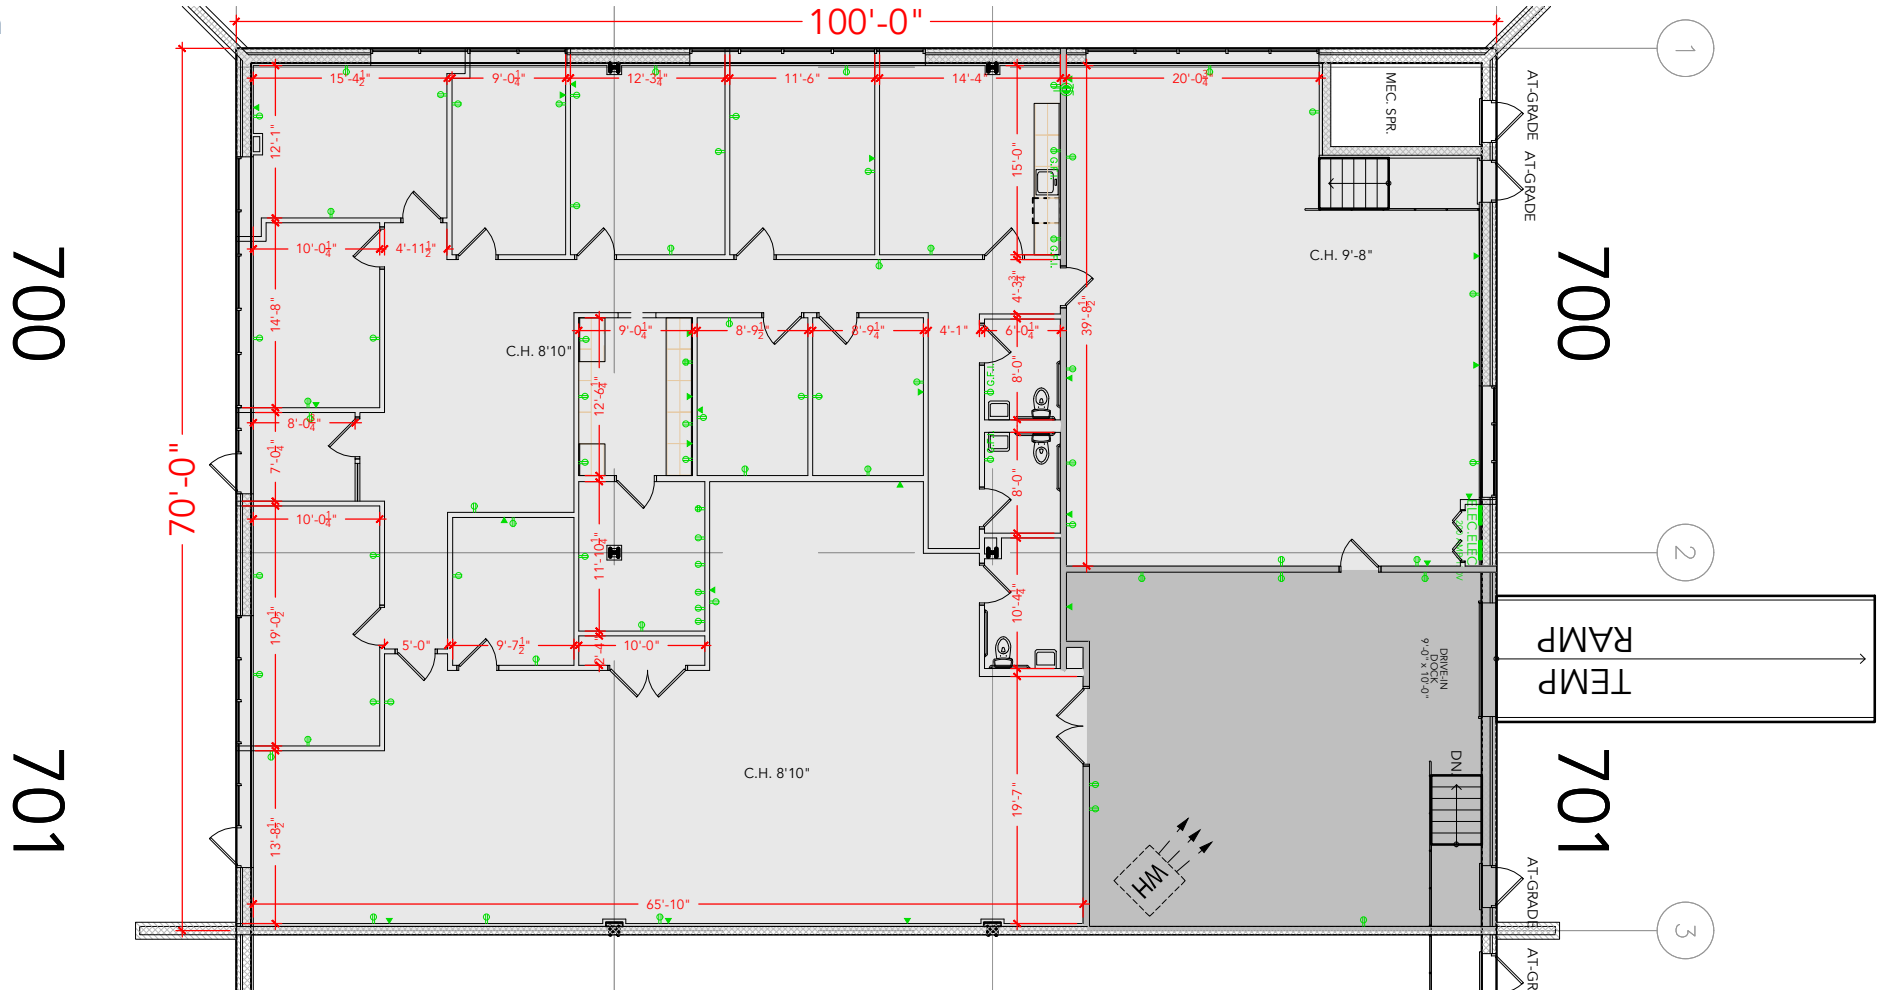

Floor Plan