


HIDDEN ROCK I

9305 GERWIG LANE COLUMBIA, MD 21046
SUITE H-L(R)


TOTAL SF AVAILABLE - 8,253 SF

OFFICE - 460 SF
WAREHOUSE SF - 7,793 SF

[Click to access 3D model](#)

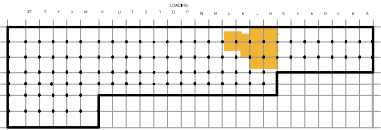

Key Plan

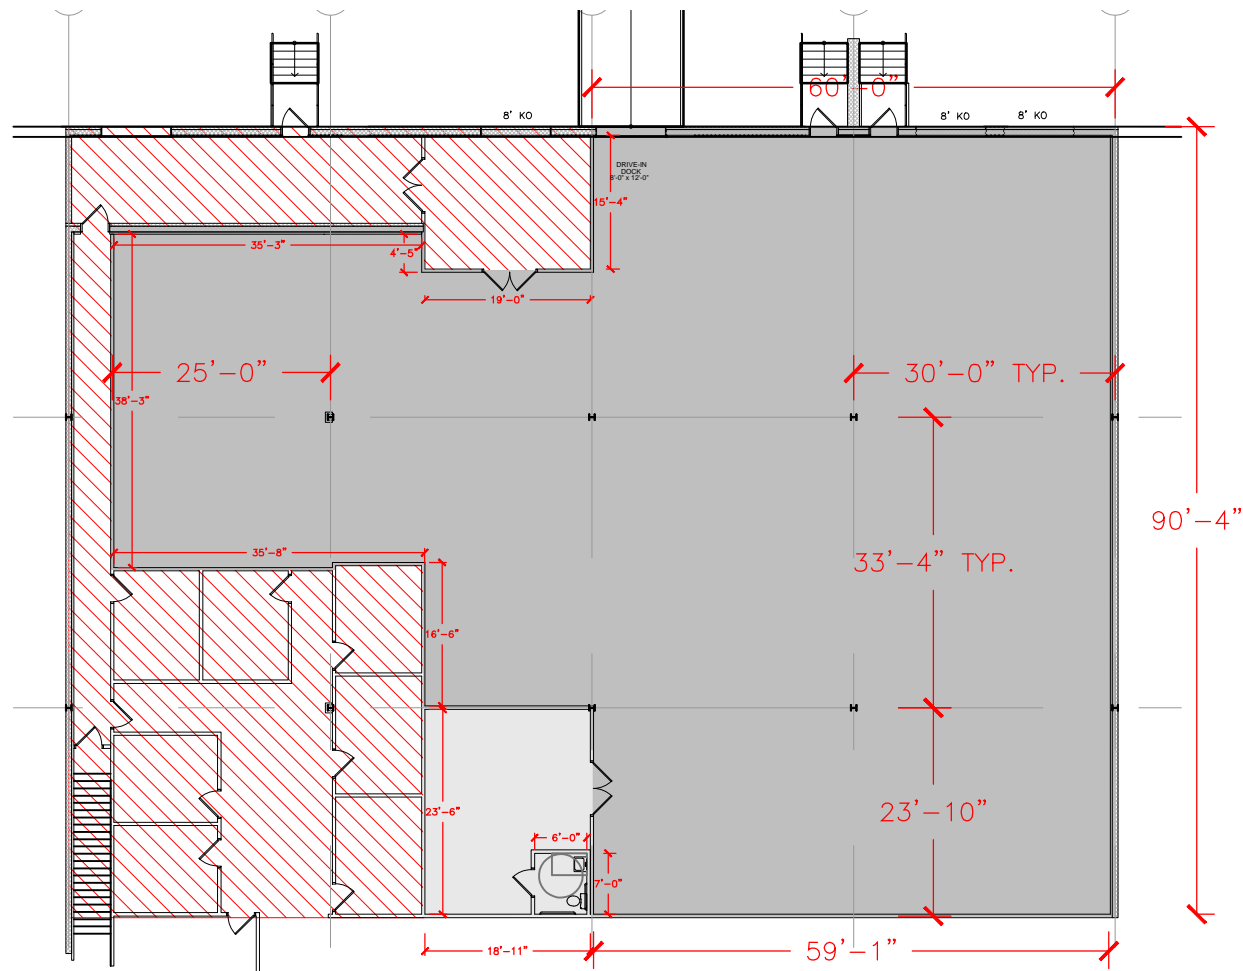

Floor Plan