



TOTAL SF AVAILABLE - 6,291 SF

OFFICE - 4,275 SF
WAREHOUSE SF - 2,016 SF

[Click to access 3D model](#)

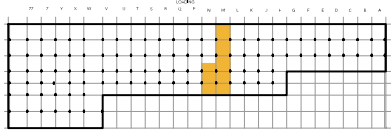

Key Plan

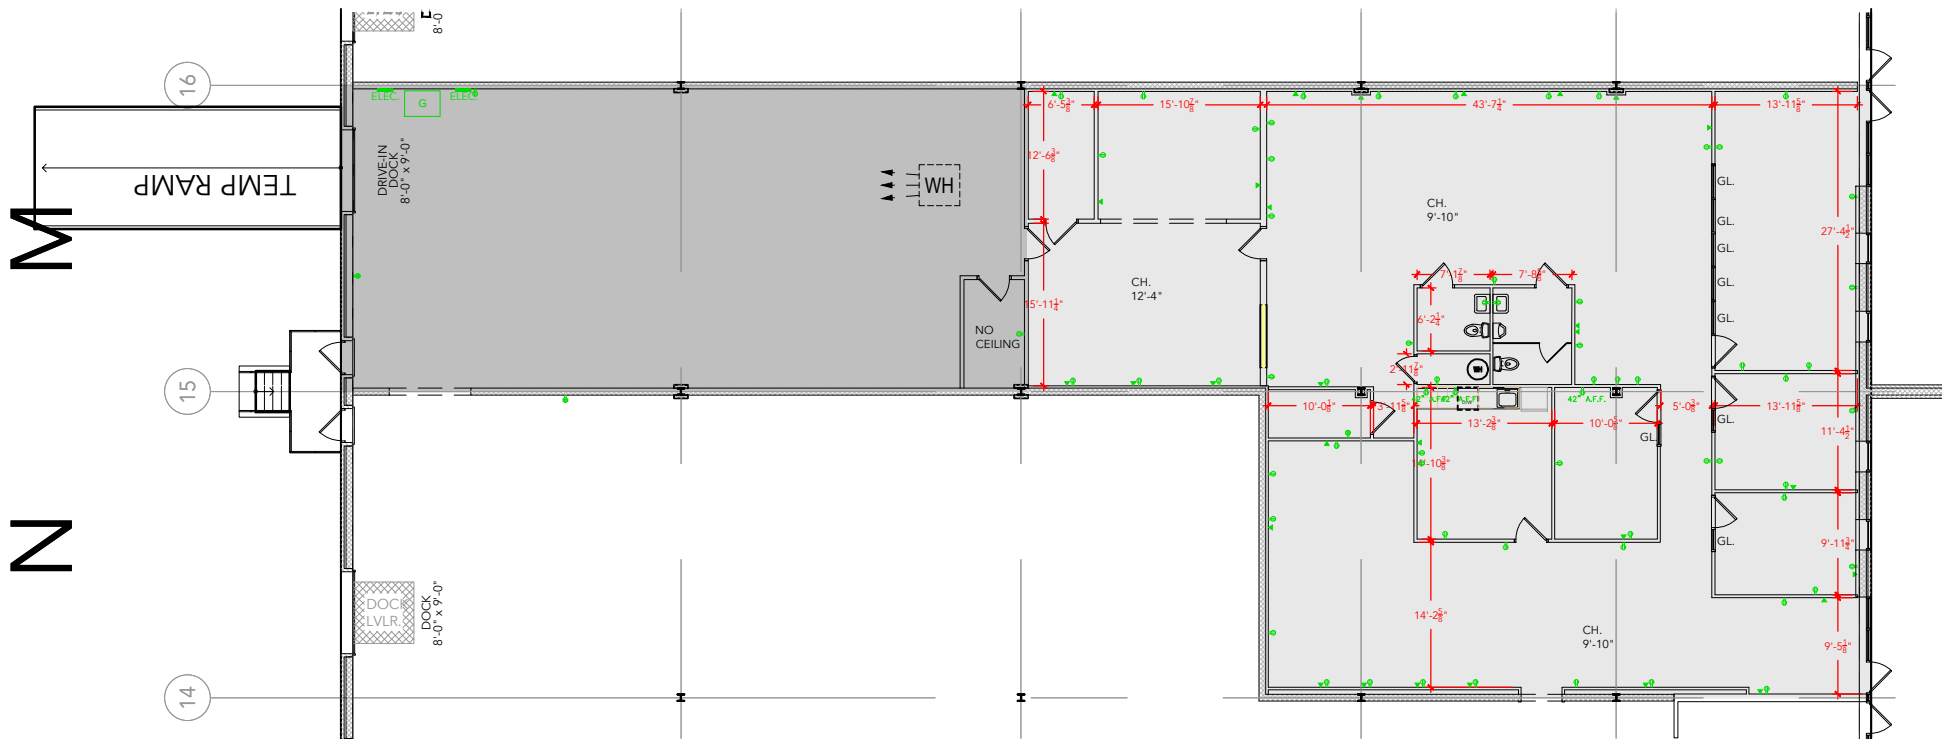

Floor Plan