


TOTAL SF AVAILABLE -6,295 RSF


OFFICE - 3,580 RSF
WAREHOUSE - 2,715 RSF

* INCLUDES % OF METER ROOM

[Click to access CADD file](#)

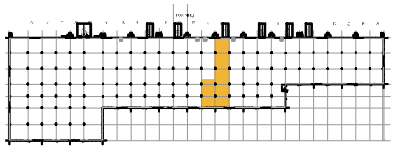

Key Plan

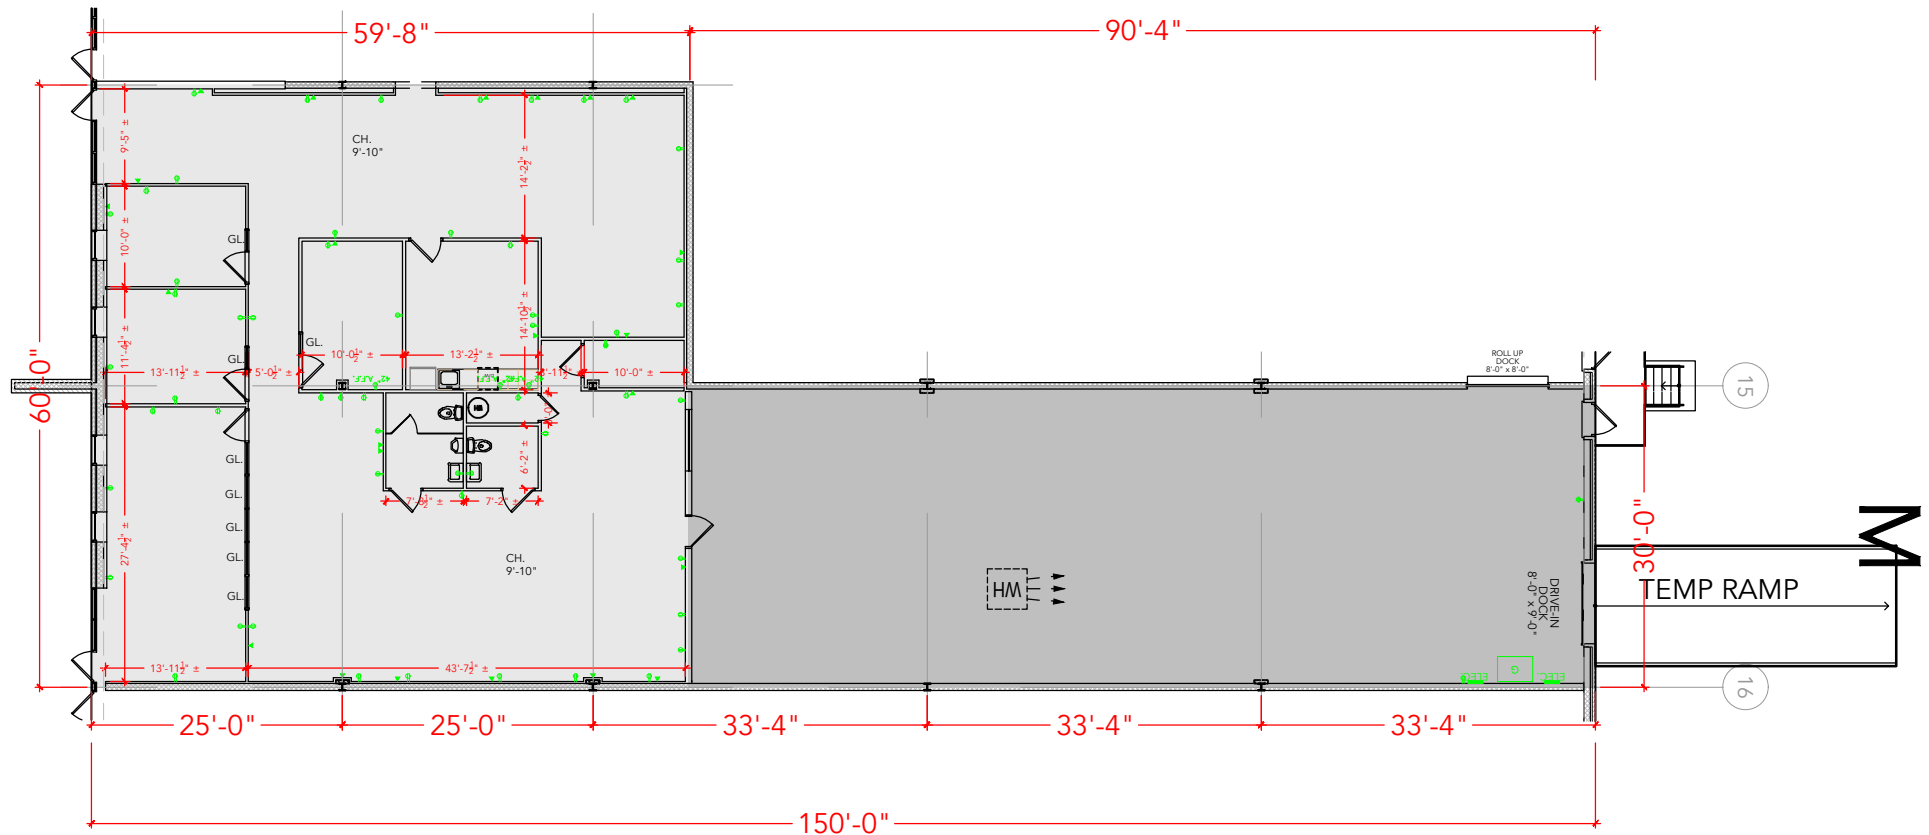

Floor Plan